

MISSISSIPPI DEPARTMENT OF NATURAL RESOURCES

Bureau of Land and Water Resources

Southport Mall

P.O. Box 10631

Jackson, Mississippi 39209

COASTAL WATER WELL DRILLERS LOG

ROUTE 1 BOX 618

BILOXI, MISS. 39537

Harrison
county well located

H
255

10/1/81 19
date well completed

LANDOWNER: Donald V. Bennett

description of formations encountered

from to

Highway Rt 1 Box 618
Biloxi, Miss
(mailing address)

Top Soil	1	3
Red Clay	3	18
Green Sand	18	60
Coarse white sand	60	90
Soft Blue Clay	90	280
fine white sand	280	300
Hard Blue Clay	300	410
fine white sand	410	425
Coarse white sand	425	465

WELL LOCATION:

sec. 16 T 6 N R 10 E
S W
4 1/2 miles North Woodmark
(distance) (direction) (nearest town)

WELL PURPOSE:

(home, irrigation, municipal, industrial) home

WELL COMPLETION DATA:

- (1) diameter (inches) 2"
 - (2) total depth (feet) 465'
 - (3) static water level (feet) 100' below above top of ground.
 - (4) casing PVC, 455'
(material) (depth)
(size) If telescope see back.
 - (5) screen 10', 455'
(length) (depth to top)
2", PVC
(size) (material)
 - (6) pump None 8 gpm
(HP) (yield gpm)
Electric
(type power)
 - (7) electric log no
(yes or no)
- (organization running log)

DEPT. OF NATURAL RESOURCES
BUREAU OF LAND & WATER RESOURCES

JAN 15 1982


RECEIVED

(8) how well bottom plugged
2" sandstone

DRILLERS REMARKS:

If well telescopes please sketch and show depths.

GROUND LEVEL

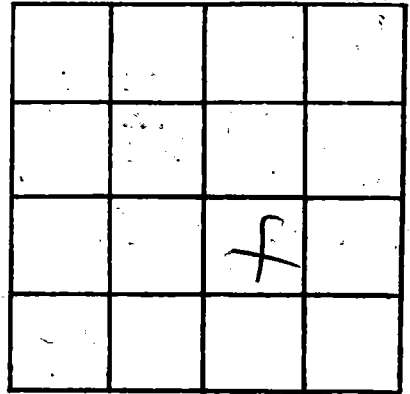

SECTION _____

Please indicate well location X.

ADDITIONAL INFORMATION

If more than one screen, show locations of each on sketch.