

MISSISSIPPI DEPARTMENT OF NATURAL RESOURCES

Bureau of Land and Water Resources

Southport Mall

P.O. Box 10631

Jackson, Mississippi 39209

COASTAL DRILLING & SERVICE CO. WATER WELL DRILLERS LOG

ROUTE 1 BOX 618

Hammond

date well completed

BILOXI, MISS

firm name

county well located

LAND SURVEY

Hammond Tract
Rochester Rd. Rt 5
Bilal, Miss
(mailing address)

description of formations encountered

from

to

<i>top soil</i>	<i>1</i>	<i>3</i>
<i>red clay</i>	<i>3</i>	<i>10</i>
<i>white soft clay</i>	<i>10</i>	<i>25</i>
<i>split blue clay</i>	<i>25</i>	<i>60</i>
<i>fine water sand</i>	<i>60</i>	<i>70</i>
<i>split blue clay</i>	<i>70</i>	<i>210</i>
<i>hard blue clay</i>	<i>210</i>	<i>310</i>
<i>fine water sand</i>	<i>310</i>	<i>320</i>
<i>good water sand</i>	<i>320</i>	<i>345</i>

WELL LOCATION:

sec *25* T *6* N R *10* E
(2 1/2 mi) *North* of *Charlottesville*
(distance) (direction) (nearest town)

WELL PURPOSE:

(home, irrigation, municipal, industrial) *home*

WELL COMPLETION DATA:

- (1) diameter (inches) *2"*
- (2) total depth (feet) *345'*
- (3) static water level (feet) *60* below top of ground
- (4) casing *PVC* *335'*
(material) (depth)
- (size) if telescope see back.
- (5) screen *10'* *335'*
(length) (depth to top)
- 2"*
(size) *PVC*
(material)
- (6) pump *Wore* *12 gpm*
(HP) (yield gpm)
- Ele*
(type power)
- (7) electric log *no*
(yes or no)

(organization running log)

(8) how well bottom plugged

2 feet water seal
DRILLERS REMARKS: *Seal*


DEPT. OF NATURAL RESOURCES
BUREAU OF LAND & WATER RESOURCES

JAN 18 1982

RECEIVED

If well telescopes please sketch and show depths.

GROUND LEVEL

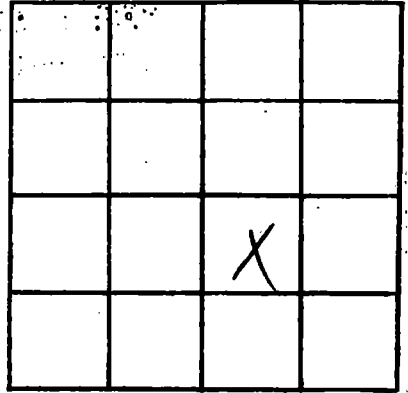

SECTION _____

Please indicate well location X.

ADDITIONAL INFORMATION

If more than one screen,
show locations of each on sketch.