

MISSISSIPPI DEPARTMENT OF NATURAL RESOURCES

Bureau of Land and Water Resources

Southport Mall

P.O. Box 10631

Jackson, Mississippi 39209

WATER WELL DRILLERS LOG

COASTAL DRILLING & SERVICE CO.

H
2160

8/30/80
date well completed

ROUTE 1 BOX 618
name

Harrison
county well located

BILOXI, MISS. 39532

LANDOWNER: Harris planner
Old Woodmarket Rd
RT 1 Biloxi Min
(mailing address)

description of formations encountered	from	to
Top Soil	1	3
Red Clay	3	20
Swamp Soil	20	60
White white Sand	60	120
Soft Blue Clay	120	310
fine water sand	310	335
hard Blue Clay	335	500
fine water sand	500	520
good water sand	520	540

WELL LOCATION:
sec 21 T 6 N R 10 E
S W
1/2 mile North Min quarter
(distance) (direction) (nearest town)

WELL PURPOSE: home
(home, irrigation, municipal, industrial)

WELL COMPLETION DATA:

(1) diameter (inches) 2"

(2) total depth (feet) 540'

(3) static water level (feet) 65' below
top of ground.

(4) casing PVC, 530'
(material) (depth)

(size) If telescope see back.

(5) screen 10', 530'
(length) (depth to top)

2", PVC
(size) (material)

(6) pump 1/2 HP, 8 GPM
(HP) (yield gpm)

Ele
(type power)

(7) electric log no
(yes or no)

(organization running log)

(8) how well bottom plugged
2" back wash valve
DRILLERS REMARKS: 19-8


DEPT. OF NATURAL RESOURCES
BUREAU OF LAND & WATER RESOURCES

JAN 15 1982

RECEIVED

If well telescopes please sketch and show depths.

GROUND LEVEL

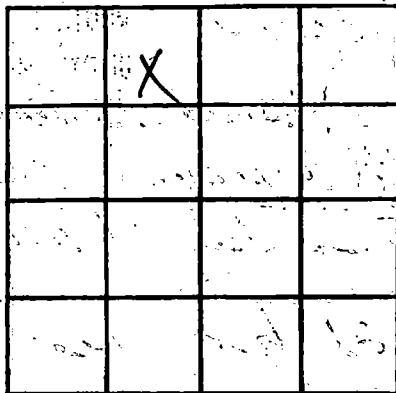

SECTION _____

Please indicate well location X.

ADDITIONAL INFORMATION

If more than one screen, show locations of each on sketch.