

MISSISSIPPI DEPARTMENT OF NATURAL RESOURCES

Bureau of Land and Water Resources

Southport Mall

P.O. Box 10631

Jackson, Mississippi 39209

COASTAL DRILLING & SERVICE CO. DRILLERS LOG

Hanson
H
2161

ROUTE 1 BOX 618

BILOXI, MISS. 39552

Hanson
county well located

11/15/81
date well completed

LANDOWNER: Hungerford
Kramer-Hedden Rd
P.O. Biloxi, Miss
(mailing address)

description of formations encountered	from	to
top soil	1	3
Red Clay	3	18
Coarse white sand	18	65
Soft Blue Clay	65	310
hard blue clay	310	440
fine water sand	440	470
hard blue clay	470	680
fine water sand	680	710
good water sand	710	765

WELL LOCATION:

sec. 24 T. 6 N. R. 10 E. W. W
Inset N
(distance) miles (direction) of (nearest town)

WELL PURPOSE:

(home, irrigation, municipal, industrial) home

WELL COMPLETION DATA:

- (1) diameter (inches) 2"
- (2) total depth (feet) 765'
- (3) static water level (feet) 55' below top of ground.
- (4) casing PVC, 735' (material), (depth)
- (size) if telescope see back.
- (5) screen 10', 735' (length), (depth to top)
- 2" (size), PVC (material)
- (6) pump 1 1/2 (HP), 14 (yield gpm)
- cc (type power)
- (7) electric log no (yes or no)

(organization running log)

(8) how well bottom plugged

Dr. Fred W. Jones
DRILLERS REMARKS: Sand Seal


DEPT. OF NATURAL RESOURCES
BUREAU OF LAND & WATER RESOURCES

FEB 15 1982

RECEIVED

If well telescopes please sketch and show depths.

GROUND LEVEL

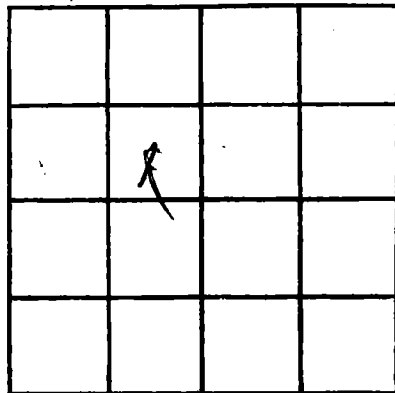

SECTION _____

Please indicate well location X.

ADDITIONAL INFORMATION

If more than one screen, show locations of each on sketch.