

MISSISSIPPI DEPARTMENT OF NATURAL RESOURCES

Bureau of Land and Water Resources

Southport Mall

P.O. Box 10631

Jackson, Mississippi 39209

COASTAL DRILLING & SERVICE CO. DRILLERS LOG

ROUTE 1 BOX 618

BILOXI, MISS. 39532

Harrison
H
2166

date well completed

owner name

county well located

LANDOWNER

Robert Roberts

description of formations encountered

from to

Woolmarket Lake
Rt 1 Biloxi Miss
(mailing address)

<u>Top Soil</u>	<u>1</u>	<u>3</u>
<u>Red Clay</u>	<u>3</u>	<u>10</u>
<u>Grey Sand</u>	<u>10</u>	<u>35</u>
<u>Dark white Sand</u>	<u>35</u>	<u>60</u>
<u>Soft Blue Clay</u>	<u>60</u>	<u>210</u>
<u>Hard Blue Clay</u>	<u>210</u>	<u>260</u>
<u>Sand water Sand</u>	<u>260</u>	<u>285</u>

WELL LOCATION:

sec 32 T 6 N R 10 E
None west Woolmarket
(distance) (direction) (nearest town)

WELL PURPOSE:

(home, irrigation, municipal, industrial) home

WELL COMPLETION DATA:

- (1) diameter (inches) 2"
- (2) total depth (feet) 285
- (3) static water level (feet) 10' below top of ground
- (4) casing PVC 275'
(material) (depth)
- (size) If telescope see back.
- (5) screen 10' 275'
(length) (depth to top)
- 2" PVC
(size) (material)
- (6) pump None 70
(HP) (yield gpm)
- ele sup
(type power)
- (7) electric log no
(yes or no)

(organization running log)

(8) how well bottom plugged

DRILLERS REMARKS

2" backwash/Well seal


DEPT. OF NATURAL RESOURCES
BUREAU OF LAND & WATER RESOURCES

MAR - 2 1982

RECEIVED

If well telescopes please sketch and show depths.

GROUND LEVEL

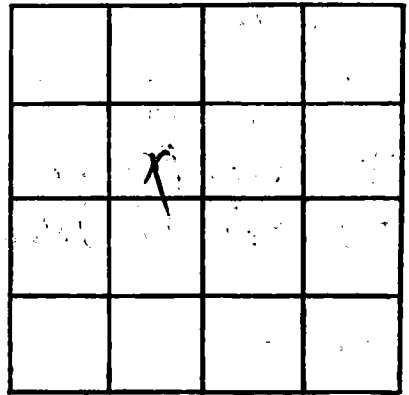

SECTION _____

Please indicate well location X.

ADDITIONAL INFORMATION

If more than one screen,
show locations of each on sketch.