

MISSISSIPPI DEPARTMENT OF NATURAL RESOURCES

Bureau of Land and Water Resources

Southport Mall

P.O. Box 10631

Jackson, Mississippi 39209

COASTAL DRILLING & WELL DRILLERS LOG SERVICE CO.

ROUTE 1 BOX 618

BILOXI, MISS. 39532

county well located

Harrison
H
2167

2/10/82
date well completed

Harrison
county well located

LANDOWNER	description of formations encountered	from	to
<u>Joe Davis</u> <u>Hwy 67</u> <u>Biloxi Miss</u> (mailing address)	<u>top soil</u>	<u>1</u>	<u>3</u>
	<u>Red Clay</u>	<u>3</u>	<u>20</u>
	<u>white sand</u>	<u>20</u>	<u>35</u>
	<u>Soft Blue Clay</u>	<u>35</u>	<u>210</u>
	<u>fine water sand</u>	<u>210</u>	<u>225</u>
	<u>hard blue clay</u>	<u>225</u>	<u>440</u>
	<u>fine water sand</u>	<u>440</u>	<u>460</u>
	<u>heavy hard clay</u>	<u>460</u>	<u>490</u>
	<u>fine water sand</u>	<u>490</u>	<u>510</u>
	<u>hard water sand</u>	<u>510</u>	<u>540</u>
WELL LOCATION: sec. <u>9</u> T. <u>6</u> N. R. <u>10</u> E. S. W. <u>5</u> miles <u>North</u> of <u>Waldal</u> (distance) (direction) (nearest town)			
WELL PURPOSE: <u>home</u> (home, irrigation, municipal, industrial)			
WELL COMPLETION DATA:			
(1) diameter (inches) <u>2"</u>			
(2) total depth (feet) <u>540'</u>			
(3) static water level (feet) <u>120'</u> below top of ground.			
(4) casing <u>PVC</u> , <u>530'</u> (material) (depth)			
(size) If telescope see back.			
(5) screen <u>10'</u> , <u>530'</u> (length) (depth to top)			
<u>2"</u> , <u>PVC</u> (size) (material)			
(6) pump <u>2 HP</u> , <u>8</u> (HP) (yield gpm)			
<u>Elc</u> (type power)			
(7) electric log <u>no</u> (yes or no)			
(organization running log)			
(8) how well bottom plugged			
<u>2" backwash plug</u> <u>Sand Seal</u> DRILLERS REMARKS			


DEPT. OF NATURAL RESOURCES
BUREAU OF LAND & WATER RESOURCES

MAR - 2 1982

RECEIVED

If well telescopes please sketch and show depths.

GROUND LEVEL

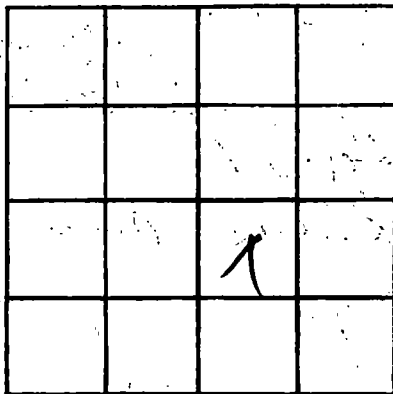

SECTION _____

Please indicate well location X.

ADDITIONAL INFORMATION

If more than one screen, show locations of each on sketch.