

MISSISSIPPI DEPARTMENT OF NATURAL RESOURCES

Bureau of Land and Water Resources

Southport Mall

P.O. Box 10631

Jackson, Mississippi 39209

WATER WELL DRILLERS LOG

Harrison
H
2168

date well completed 2/27, 1982 firm name Lyman Well Co. county well located HARRISON

LANDOWNER: Switzer
Dunde wood lane
Biloxi, MS
 (mailing address)

description of formations encountered	from	to
<u>Red Sand & White Clay</u>	<u>0</u>	<u>50</u>
<u>Blue grey clay</u>	<u>50</u>	<u>160</u>
<u>Blue Clay & Fine Sand</u>	<u>160</u>	<u>220</u>
<u>good sand</u>	<u>220</u>	<u>306</u>

WELL LOCATION:
 sec 28 T 7 N R 10 E
2 miles N/E of Woodmark
 (distance) (direction) (nearest town)

WELL PURPOSE: Home
 (home, irrigation, municipal, industrial)

WELL COMPLETION DATA:
 (1) diameter (inches) 4"
 (2) total depth (feet) 306
 (3) static water level (feet) 65 below top of ground
 (4) casing PVC, 286,
4" (material) (depth)
4" (size) if telescope see back.
 (5) screen 20', 306
4" (length) (depth to top)
4", PVC (size) (material)
 (6) pump 1/2 HP, 120
1/2 HP (type power) (yield gpm)
 (7) electric log no
no (yes or no)
 (organization running log) Soud Shark
 (8) how well bottom plugged Soud Shark


DEPT. OF NATURAL RESOURCES
 BUREAU OF LAND & WATER RESOURCES

APR 20 1982

DRILLERS REMARKS:

If well telescopes please sketch and show depths.

GROUND LEVEL

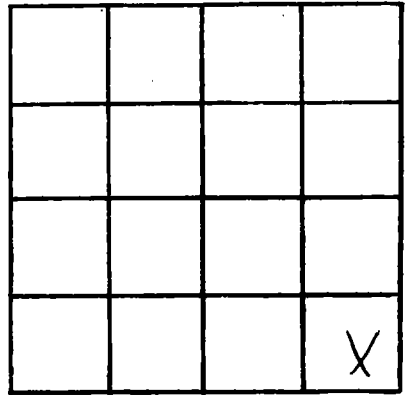

SECTION 6

Please indicate well location X.

ADDITIONAL INFORMATION

If more than one screen, show locations of each on sketch.