

MISSISSIPPI DEPARTMENT OF NATURAL RESOURCES

Bureau of Land and Water Resources

Southport Mall

P.O. Box 10631

Jackson, Mississippi 39209

WATER WELL DRILLERS LOG

Harrison
H
2169

March 8 1982
date well completed

Duncan Well Drilling
firm name

Harrison
county well located

LANDOWNER: East Whittmore
Rt. 1, Box 628
Lancier, Ms.
(mailing address)

description of formations encountered	from	to
Clay	0	20
Sand	20	60
Blue Clay	60	250
fine Sand	250	290
Course Sand	290	315

WELL LOCATION:
sec 30 T 6 N R 10 E
7 miles (distance) W. of Roman (direction) (nearest town)

WELL PURPOSE: Home
(home, irrigation, municipal, industrial)

WELL COMPLETION DATA:

(1) diameter (inches) 2"

(2) total depth (feet) 315 feet

(3) static water level (feet) 20' below top of ground

(4) casing PVC (material) 305' (depth)

(size) if telescope see back.

(5) screen 10' (length) 315' (depth to top)

2" (size) PVC (material)

(6) pump (HP) (yield gpm)

electric (type power)

(7) electric log (yes or no)

(organization running log)

(8) how well bottom plugged Sand
short

DRILLERS REMARKS: Owner had his own pump


DEPT. OF NATURAL RESOURCES
BUREAU OF LAND & WATER RESOURCES

AUG 30 1982

RECEIVED

If well telescopes please sketch and show depths.

GROUND LEVEL

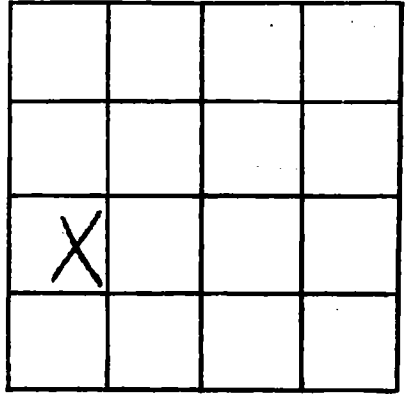

SECTION 30

Please indicate well location X.

ADDITIONAL INFORMATION

A series of horizontal lines for writing additional information, starting below the 'ADDITIONAL INFORMATION' header and extending to the bottom of the page.

If more than one screen, show locations of each on sketch.