

MISSISSIPPI DEPARTMENT OF NATURAL RESOURCES

Bureau of Land and Water Resources

Southport Mall

P.O. Box 10631

Jackson, Mississippi 39209

WATER WELL DRILLERS LOG

Harrison
H
2171

Sept. 30 1982 Duncan Well Drilling Harrison
 date well completed firm name county well located

LANDOWNER: Curtis Bruland
Rt. 1 Box 268
Shuffport, Ms.
 (mailing address)

description of formations encountered	from	to
<u>Clay</u>	<u>0</u>	<u>40</u>
<u>Sand clay mixed</u>	<u>40</u>	<u>75</u>
<u>fine sand</u>	<u>75</u>	<u>130</u>
<u>Course Sand</u>	<u>130</u>	<u>145</u>

WELL LOCATION:
 sec. 31 T. 6 N. R. 10 E.
5 miles (distance) E (direction) of North (nearest town)

WELL PURPOSE: home
 (home, irrigation, municipal, industrial)

WELL COMPLETION DATA:

(1) diameter (inches) 2"

(2) total depth (feet) 145 ft.

(3) static water level (feet) 20' below above top of ground.

(4) casing PVC 135'
 (material) (depth)

(size) If telescope see back.

(5) screen 10' 135'
 (length) (depth to top)

(size) (material) 2" PVC

(6) pump 1 10
 (HP) (yield gpm)

(type power) electric

(7) electric log (yes or no) _____

(organization running log) _____

(8) how well bottom plugged Sand
Shank

DRILLERS REMARKS: _____


DEPT. OF NATURAL RESOURCES
 BUREAU OF LAND & WATER RESOURCES

JAN 21 1983

RECEIVED

If well telescopes please sketch and show depths.

GROUND LEVEL

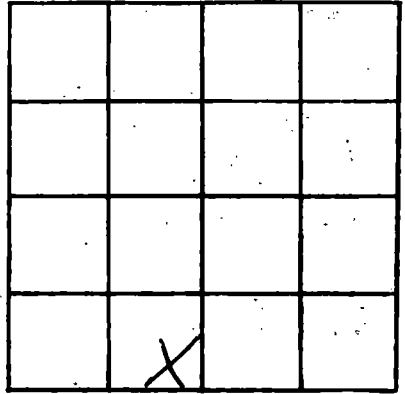

SECTION 31

Please indicate well location X.

ADDITIONAL INFORMATION

If more than one screen,
show locations of each on sketch.