

MISSISSIPPI DEPARTMENT OF NATURAL RESOURCES

Bureau of Land and Water Resources

Southport Mall

P.O. Box 10631

Jackson, Mississippi 39209

COASTAL DRILLING & SERVICE CO. WATER WELL DRILLERS LOG

ROUTE 1 BOX 618

firm name

Harrison

county well located

Harrison
H
2172

10/6/82
date well completed

BILOXI, MISS, 39532

LANDOWNER: *Ray West*
Rt 1 Box 822A
Biloxi, ms
(mailing address)

description of formations encountered

from

to

WELL LOCATION:
sec *34* T *6* N R *10*
S *W*
Power line
(distance) (direction) of (nearest town)

<i>top soil</i>	<i>1</i>	<i>3</i>
<i>Red Clay</i>	<i>3</i>	<i>15</i>
<i>Blue white sand</i>	<i>15</i>	<i>40</i>
<i>Red Clay</i>	<i>40</i>	<i>65</i>
<i>supp sand</i>	<i>65</i>	<i>90</i>
<i>soft blue clay</i>	<i>90</i>	<i>270</i>
<i>fine water soft</i>	<i>270</i>	<i>270</i>
<i>hard blue clay</i>	<i>270</i>	<i>460</i>
<i>fine water sand</i>	<i>460</i>	<i>490</i>
<i>good water sand</i>	<i>490</i>	<i>540</i>

WELL PURPOSE: *home*
(home, irrigation, municipal, industrial)

WELL COMPLETION DATA:

- (1) diameter (inches) *4 1/2"*
- (2) total depth (feet) *540'*
- (3) static water level (feet) *60'* below top of ground.
- (4) casing *PVC*, *525'* (material) (depth)
4 1/2" If telescope see back. (size)
- (5) screen *15'*, *525'* (length) (depth to top)
2" (size) *PVC* (material)
- (6) pump *2 HP*, *25* (HP) (yield gpm)
3/4 (type power)
- (7) electric log *no* (yes or no)

(organization running log)

(8) how well bottom plugged

2nd bottom plugged
DRILLERS REMARKS: *198*

DEPT. OF NATURAL RESOURCES
BUREAU OF LAND & WATER RESOURCES

RECEIVED
DEC - 1 1982

If well telescopes please
sketch and show depths.

GROUND LEVEL


160' - 4" Pit Casings

365' 2" Pit Casings

15' 2" Pit Screen

2" lock wash valve

19-B

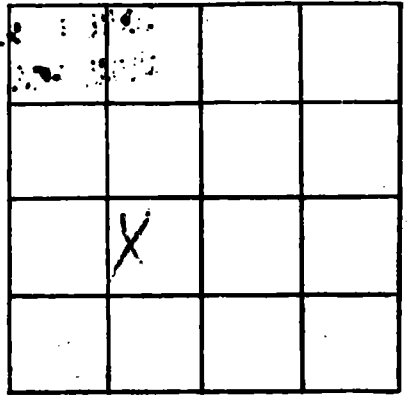

SECTION _____

Please indicate well location X.

ADDITIONAL INFORMATION

If more than one screen,
show locations of each on sketch.