

MISSISSIPPI DEPARTMENT OF NATURAL RESOURCES

Bureau of Land and Water Resources

Southport Mall

P.O. Box 10631

Jackson, Mississippi 39209

WATER WELL DRILLERS LOG

COASTAL DRILLING & SERVICE CO.

Harrison
H
2173

10/18/82
date well completed

19 ROUTE 1 BOX 618

firm name

Harrison
county well located

BILOXI MISS 39532

LANDOWNER: M. R. Maly
Jim Boyd Road
Biloxi MS 39532
(mailing address)

description of formations encountered	from	to
top soil	1	3
red clay	3	15
white sand	15	60
soft blue clay	60	165
fine water sand	165	210
soft blue clay	210	320
hard blue clay	320	570
fine water sand	570	570
hard blue clay	570	680
fine water sand	680	700
soft water sand	700	730

WELL LOCATION:
sec. 34 T. 6 N. R. 10 E.
Inset F of F
(distance) (direction) of (nearest town)

WELL PURPOSE: home
(home, irrigation, municipal, industrial)

WELL COMPLETION DATA:

(1) diameter (inches) 2"

(2) total depth (feet) 730'

(3) static water level (feet) 45' below above top of ground.

(4) casing pic 720'
(material) (depth)

(size) if telescope see back.

(5) screen 10' 720'
(length) (depth to top)

2" pic
(size) (material)

(6) pump Clare 12
(HP) (yield gpm)

5kw
(type power)

(7) electric log no
(yes or no)

(organization running log)


(8) how well bottom plugged 2' back with slush
DRILLERS REMARKS: 19-6

DEPT. OF NATURAL RESOURCES
BUREAU OF LAND & WATER RESOURCES

DEC-1 1982
RECEIVED

If well telescopes please sketch and show depths.

GROUND LEVEL

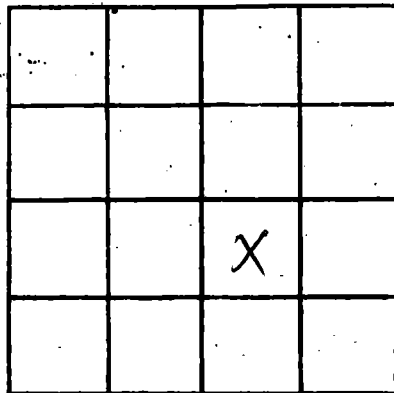

SECTION _____

Please indicate well location X.

ADDITIONAL INFORMATION

If more than one screen, show locations of each on sketch.