

**MISSISSIPPI DEPARTMENT OF NATURAL RESOURCES**  
**Bureau of Land and Water Resources**  
 Southport Mall  
 P.O. Box 10631  
 Jackson, Mississippi 39209  
**WATER WELL DRILLERS LOG**

Harrison  
H  
2179

1/2 1982 Hyman Well Co. Harrison  
 date well completed firm name county well located

LANDOWNER: Ronald Green  
936 Dewey Circle  
Biloxi 39531  
 (mailing address)

description of formations encountered	from	to
<u>Red sand</u>	<u>0</u>	<u>100</u>
<u>Granite nub</u>	<u>100</u>	<u>260</u>
<u>fine powder sand</u>	<u>260</u>	<u>320</u>
<u>Blue clay</u>	<u>320</u>	<u>400</u>
<u>Coal sand</u>	<u>400</u>	<u>452</u>

WELL LOCATION:  
 sec. 6 T. 6 N. R. 10 E.  
13 miles N/E of apt.  
 (distance) (direction) (nearest town)

WELL PURPOSE:  
 (home, irrigation, municipal, industrial)

- WELL COMPLETION DATA:
- (1) diameter (inches) 2"
  - (2) total depth (feet) 452
  - (3) static water level (feet) 60' below above top of ground.
  - (4) casing PVC 3442  
 (material) (depth)  
2" If telescope see back.  
 (size)
  - (5) screen 10' 452  
 (length) (depth to top)  
2" PVC  
 (size) (material)
  - (6) pump 1 12  
 (HP) (yield gpm)  
Elec.  
 (type power)
  - (7) electric log NO  
 (yes or no)  
NO  
 (organization running log)
  - (8) how well bottom plugged Sand  
Shank

DEPT. OF NATURAL RESOURCES  
 BUREAU OF LAND & WATER RESOURCES


FEB 28 1983

**RECEIVED**

DRILLERS REMARKS:

If well telescopes please sketch and show depths.

GROUND LEVEL

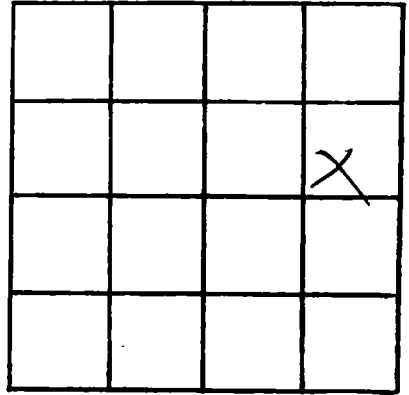

SECTION 6

Please indicate well location X.

ADDITIONAL INFORMATION

If more than one screen,  
show locations of each on sketch.