

MISSISSIPPI DEPARTMENT OF NATURAL RESOURCES

Bureau of Land and Water Resources

Southport Mall

P.O. Box 10631

Jackson, Mississippi 39209

WATER WELL DRILLERS LOG

Harrison  
H  
2181

11/5/82 1982  
date well completed  
Lynnan Well Co  
firm name  
Harrison  
county well located

LANDOWNER: Mr. Brewer  
Rt. 2, Box 130  
Bellevue, Miss.  
(mailing address)

description of formations encountered	from	to
white sand	0	40
gravel		
Blue Gravel	40	120
Clay		
Crumbly Clay + Fine Sand	120	260
Medium Good Sand	260	320

WELL LOCATION:  
sec. 30 T. 6 N. R. 10 E.  
6 miles (distance) S of Wood Market (nearest town)

WELL PURPOSE: Home  
(home, irrigation, municipal, industrial)

- WELL COMPLETION DATA:
- (1) diameter (inches) 2"
  - (2) total depth (feet) 320'
  - (3) static water level (feet) 56 below top of ground.
  - (4) casing PVC 300' (material) (depth)  
2" (size) If telescope see back.
  - (5) screen 20' 300' (length) (depth to top)  
2" (size) PVC (material)
  - (6) pump 1 10 (HP) (yield gpm)  
electric (type power)
  - (7) electric log NO (yes or no)  
NO (organization running log)
  - (8) how well bottom plugged sand shark


DRILLERS REMARKS:

MISSISSIPPI DEPARTMENT OF NATURAL RESOURCES  
BUREAU OF LAND AND WATER RESOURCES

APR 25 1982

If well telescopes please sketch and show depths.

GROUND LEVEL

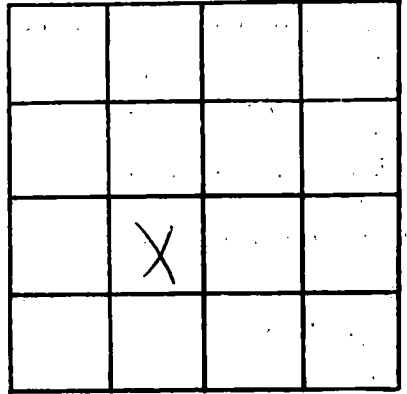

SECTION 6

Please indicate well location X.

ADDITIONAL INFORMATION

If more than one screen, show locations of each on sketch.