

MISSISSIPPI DEPARTMENT OF NATURAL RESOURCES

Bureau of Land and Water Resources

Southport Mall

P.O. Box 10631

Jackson, Mississippi 39209

WATER WELL DRILLERS LOG

Harrison
H
2184

Jan 24 1983 Duncan Well Drilling Harrison
 date well completed firm name county well located

LANDOWNER: <u>RR, Detwiler Builders</u>	Description of formations encountered	from	to
<u>Rt. 2 Box 213 F</u>	<u>clay</u>	<u>0</u>	<u>27</u>
<u>Long Beach Ms. 39560</u> (mailing address)	<u>Sand</u>	<u>27</u>	<u>73</u>
WELL LOCATION:	<u>Blue clay</u>	<u>73</u>	<u>240</u>
sec. <u>31</u> T. <u>6</u> N. R. <u>10</u> E	<u>fine Sand</u>	<u>240</u>	<u>280</u>
<u>5</u> miles <u>W.</u> of <u>Apogon</u>	<u>Blue clay</u>	<u>280</u>	<u>300</u>
(distance) (direction) (nearest town)	<u>fine Sand</u>	<u>300</u>	<u>420</u>
WELL PURPOSE: <u>Home</u>	<u>Course Sand</u>	<u>420</u>	<u>450</u>
(home, irrigation, municipal, industrial)			
WELL COMPLETION DATA:			
(1) diameter (inches) <u>2"</u>			
(2) total depth (feet) <u>450 ft.</u>			
(3) static water level (feet) <u>20'</u> ^{below} <u>above</u> top of ground.			
(4) casing <u>PVC</u> <u>440'</u> (material) (depth)			
(size) If telescope see back.			
(5) screen <u>10'</u> <u>440'</u> (length) (depth to top)			
(size) <u>2"</u> <u>PVC</u> (material)			
(6) pump <u>1</u> <u>10</u> (HP) (yield gpm)			
<u>electric</u> (type power)			
(7) electric log <u> </u> (yes or no)			
(organization running log)			
(8) how well bottom plugged <u>Sand</u>			
<u>Shark</u>			


MISSISSIPPI DEPARTMENT OF NATURAL RESOURCES
 BUREAU OF LAND & WATER RESOURCES

AUG 18 1983

RECEIVED

If well telescopes please sketch and show depths.

GROUND LEVEL

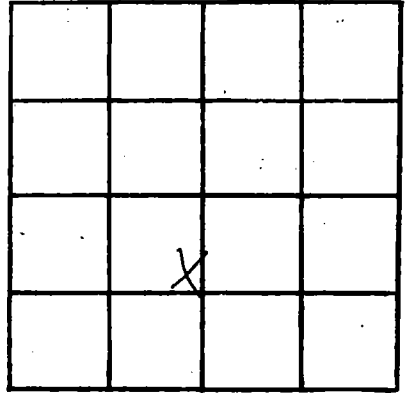

SECTION 31

Please indicate well location X.

ADDITIONAL INFORMATION

If more than one screen, show locations of each on sketch.