

MISSISSIPPI DEPARTMENT OF NATURAL RESOURCES

Bureau of Land and Water Resources

Southport Mall

P.O. Box 10631

Jackson, Mississippi 39209

WATER WELL DRILLERS LOG

<i>Harrison</i>
<i>H</i>
<i>2186</i>

March 12 1983 *Duncan Well Drilling Harrison*
 date well completed firm name county well located

LANDOWNER: <i>Gregory Tolson</i> <i>Rt. 5</i>	description of formations encountered	from	to
<i>Hulport, Ms.</i> (mailing address)	<i>Sand & Clay</i>	<i>0</i>	<i>30</i>
WELL LOCATION: sec. <i>31</i> T <i>6</i> N R <i>10</i> E <i>5</i> miles <i>W.</i> of <i>Amaze</i> (distance) (direction) (nearest town)	<i>Blue Clay</i>	<i>30</i>	<i>83</i>
WELL PURPOSE: (home, irrigation, municipal, industrial)	<i>course sand</i>	<i>83</i>	<i>100</i>
WELL COMPLETION DATA: (1) diameter (inches) <i>2"</i> (2) total depth (feet) <i>100 ft.</i> (3) static water level (feet) <i>20'</i> below above top of ground. (4) casing <i>PVC</i> <i>90</i> (material) (depth) <i>—</i> If telescope see back. (5) screen <i>10'</i> <i>90'</i> (length) (depth to top) <i>2"</i> <i>PVC</i> (size) (material) (6) pump <i>—</i> <i>—</i> (HP) (yield gpm) <i>—</i> (type power) (7) electric log <i>—</i> (yes or no) <i>—</i> (organization running log) (8) how well bottom plugged <i>Sand</i> <i>short</i>			
DRILLERS REMARKS: <i>owner</i> <i>Had his own</i> <i> pump</i>			


DEPT. OF NATURAL RESOURCES
BUREAU OF LAND & WATER RESOURCES

AUG 12 1983

RECEIVED

If well telescopes please sketch and show depths.

GROUND LEVEL

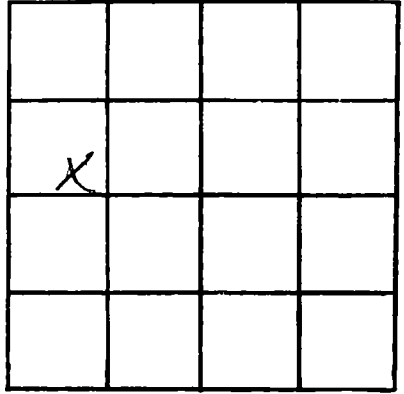

SECTION 31

Please indicate well location X.

ADDITIONAL INFORMATION

Lined area for providing additional information, consisting of approximately 20 horizontal lines.

If more than one screen, show locations of each on sketch.