

MISSISSIPPI DEPARTMENT OF NATURAL RESOURCES

Bureau of Land and Water Resources

Southport Mall

P.O. Box 10631

Jackson, Mississippi 39209

WATER WELL DRILLERS LOG

Harrison  
H  
2188

6/4 1983 Braden Pump & Well Dr. Harrison Inc.  
 date well completed firm name county well located

LANDOWNER: Dennis Riley  
Jim Byrd Rd  
Woolmarket, Ms.  
 (mailing address)

description of formations encountered	from	to
	<u>red + white clay</u>	<u>0</u>
<u>sand</u>	<u>20</u>	<u>120</u>
<u>clay</u>	<u>120</u>	<u>270</u>
<u>sand</u>	<u>270</u>	<u>278</u>
<u>clay</u>	<u>278</u>	<u>410</u>
<u>sand</u>	<u>410</u>	<u>500</u>
<u>clay</u>	<u>500</u>	<u>560</u>
<u>sand + clay</u>	<u>560</u>	<u>580</u>
<u>sand</u>	<u>580</u>	<u>610</u>
<u>clay</u>	<u>610</u>	<u>620</u>

WELL LOCATION:  
 sec. 34 T. 6 N. R. 10 E. S. 1 W.  
1 1/2 miles E of Woolmarket  
 (distance) (direction) (nearest town)

WELL PURPOSE: Home  
 (home, irrigation, municipal, industrial)

- WELL COMPLETION DATA:
- (1) diameter (inches) 4" X 2"
  - (2) total depth (feet) 620
  - (3) static water level (feet) 25 below top of ground.
  - (4) casing PVC 600'  
 (material) (depth)  
4 X 2 if telescope see back.  
 (size)
  - (5) screen 10' 600'  
 (length) (depth to top)  
2" PVC underbar  
 (size) (material)
  - (6) pump 1 (HP) (yield gpm)  
220 V  
 (type power)
  - (7) electric log no (yes or no)  
 (organization running log)
  - (8) how well bottom plugged PVC  
sandbar

DRILLERS REMARKS: 10 ft  
tailpipe

DEPT. OF NATURAL RESOURCES  
 BUREAU OF LAND & WATER RESOURCES

JUN 18 1983

RECEIVED

If well telescopes please sketch and show depths.


GROUND LEVEL

200' 4" PVC

400' 2" PVC

PVC screen 10'

10' tail pipe

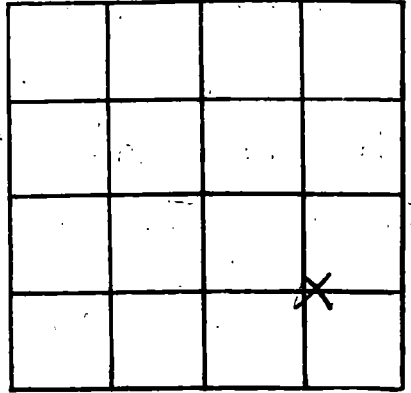

SECTION 37

Please indicate well location X.

ADDITIONAL INFORMATION

If more than one screen, show locations of each on sketch.