

MISSISSIPPI DEPARTMENT OF NATURAL RESOURCES
Bureau of Land and Water Resources
 Southport Mall
 P.O. Box 10631
 Jackson, Mississippi 39209
WATER WELL DRILLERS LOG

Harrison
H
2190

April 5 1983 Kevin Ladner, Harrison
 date well completed firm name county well located

LANDOWNER: Kevin Ladner
Dec Street
Southport, Ms. 39503
 (mailing address)

description of formations encountered	from	to
Clay	0	27
Clay & Sand	27	73
Blue Clay	73	230
fine Sand	230	270
Blue Clay	270	338
sand coarse	338	399

WELL LOCATION:
 sec 31 T. 6 N R. 10 E
5 miles W of Spman
 (distance) (direction) (nearest town)

WELL PURPOSE: home
 (home, irrigation, municipal, industrial)

WELL COMPLETION DATA:

(1) diameter (inches) 2"

(2) total depth (feet) 399 ft.

(3) static water level (feet) 30' below above top of ground.

(4) casing PVC, 389,
 (material) (depth)

— if telescope see back.
 (size)

(5) screen 10, 389
 (length) (depth to top)

2", PVC
 (size) (material)

(6) pump 1 (HP) 8 (yield gpm)

electric
 (type power)

(7) electric log —
 (yes or no)

—
 (organization running log)

(8) how well bottom plugged Sand
Shark

DRILLERS REMARKS:


DEPT. OF NATURAL RESOURCES
 BUREAU OF LAND & WATER RESOURCES

AUG 18 1983

RECEIVED

If well telescopes please sketch and show depths.

GROUND LEVEL

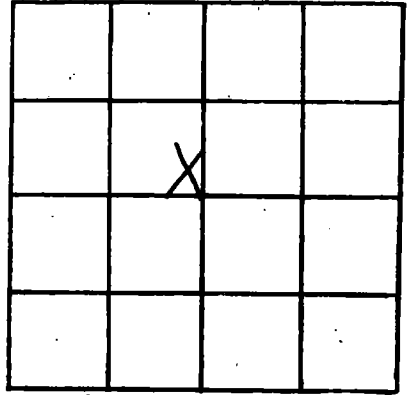

SECTION 31

Please indicate well location X.

ADDITIONAL INFORMATION

Lined area for additional information.

If more than one screen, show locations of each on sketch.