

MISSISSIPPI DEPARTMENT OF NATURAL RESOURCES

Bureau of Land and Water Resources

Southport Mall

P.O. Box 10631

Jackson, Mississippi 39209

WATER WELL DRILLERS LOG

<u>Harrison</u>
<u>H</u>
<u>2191</u>

April 21 1983 Duncan Well Drilling Harrison
 date well completed firm name county well located

LANDOWNER: T. P. Hulea
Pl. 11 Box 48
Sheppard, Ms. 39503
 (mailing address)

description of formations encountered	depth	
	from	to
<u>clay</u>	<u>0</u>	<u>20</u>
<u>sand</u>	<u>20</u>	<u>35</u>
<u>Blue Clay</u>	<u>35</u>	<u>160</u>
<u>Course Sand</u>	<u>160</u>	<u>189</u>

WELL LOCATION:
 sec 33 T 6 N R 10 E
1/4 miles E of Sheppard
 (distance) (direction) (nearest town)

WELL PURPOSE:
 (home, irrigation, municipal, industrial)

WELL COMPLETION DATA:
 (1) diameter (inches) 2"
 (2) total depth (feet) 189 ft.
 (3) static water level (feet) _____ below/above top of ground.
 (4) casing PVC, 179'
 (material) (depth)
 _____ (size) if telescope see back.
 (5) screen 10', 179'
 (length) (depth to top)
2", PVC
 (size) (material)
 (6) pump _____ (HP) _____ (yield gpm)
 _____ (type power)
 (7) electric log _____ (yes or no)
 _____ (organization running log)
 (8) how well bottom plugged Sand
Shark

DRILLERS REMARKS: Installed
no pump


DEPT. OF NATURAL RESOURCES
 BUREAU OF LAND & WATER RESOURCES

AUG 12 1983

RECEIVED

If well telescopes please sketch and show depths.

GROUND LEVEL

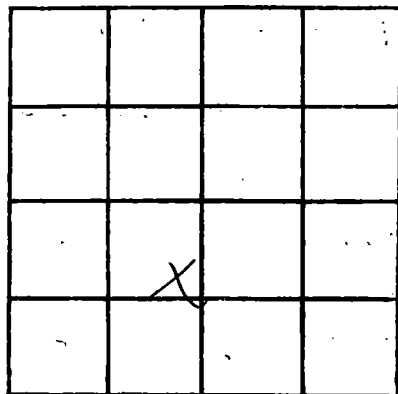

SECTION 33

Please indicate well location X.

ADDITIONAL INFORMATION

If more than one screen, show locations of each on sketch.