

MISSISSIPPI DEPARTMENT OF NATURAL RESOURCES

Bureau of Land and Water Resources

Southport Mall

P.O. Box 10631

Jackson, Mississippi 39209

WATER WELL DRILLERS LOG

<i>Harrison</i>
<i>H</i>
<i>2193</i>

June 28 19*83* *Duncan Well Drilling Harrison*
 date well completed firm name county well located

LANDOWNER: *B. N. Hughes*
151 Eden Place
Biloxi, Miss
 (mailing address)

description of formations encountered	from	to
<i>White Clay</i>	<i>0</i>	<i>30</i>
<i>Blue Clay</i>	<i>30</i>	<i>250</i>
<i>Coarse Sand</i>	<i>250</i>	<i>275</i>

WELL LOCATION:
 sec *31* T *6* N R *9* E
15 miles *N* of *Biloxi*
 (distance) (direction) (nearest town)

WELL PURPOSE: *Home*
 (home, irrigation, municipal, industrial)

WELL COMPLETION DATA:

- (1) diameter (inches) *4"*
- (2) total depth (feet) *275 ft.*
- (3) static water level (feet) *8* below above top of ground.
- (4) casing *PVC 265*
 (material) (depth)
- (size) If telescope see back.
- (5) screen *10'* *265'*
 (length) (depth to top)
- 2"* *PVC*
 (size) (material)
- (6) pump *1* *8*
 (HP) (yield gpm)
- electric*
 (type power)
- (7) electric log *—*
 (yes or no)
- (organization running log)
- (8) how well bottom plugged *Sand*
shank

DRILLERS REMARKS: *—*


DEPT. OF NATURAL RESOURCES
 BUREAU OF LAND & WATER RESOURCES

AUG 15 1983

RECEIVED

If well telescopes please sketch and show depths.

GROUND LEVEL

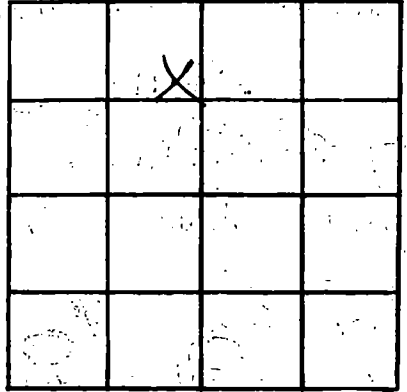

SECTION 31

Please indicate well location X.

ADDITIONAL INFORMATION

If more than one screen, show locations of each on sketch.