

MISSISSIPPI DEPARTMENT OF NATURAL RESOURCES

Bureau of Land and Water Resources

Southport Mall

P.O. Box 10631

Jackson, Mississippi 39209

WATER WELL DRILLERS LOG
COASTAL DRILLING & SERVICE CO.

ROUTE 1 BOX 618

firm name
BILOXI MISS. 39532

county well located

Hanson
H
2194

date well completed 11/1/83

LANDOWNER Jerry Hanson
Pt 11 Box 96
Biloxi MS
(mailing address)

description of formations encountered

from to

Top Soil	1	3
Red Clay	3	40
Consolidated Sand	40	65
Soft Blue Clay	65	210
Hard Blue Clay	210	300
fine water sand	300	320
good water sand	320	340

WELL LOCATION:

sec. 4 T. 6 N. R. 10 E.
Washburn
(distance) (direction) (nearest town)

WELL PURPOSE:

(home, irrigation, municipal, industrial)

WELL COMPLETION DATA:

- (1) diameter (inches) 2"
- (2) total depth (feet) 340'
- (3) static water level (feet) 45' below top of ground.
- (4) casing (material) PVC (depth) 330'
- (size) If telescope see back.
- (5) screen (length) 10' (depth to top) 330'
- (size) (material) PVC
- (6) pump (HP) 1/2 (yield gpm) 13
- (type power) 5hp
- (7) electric log (yes or no) no

(organization running log)

(8) how well bottom plugged

2" backwash valve

DRILLERS REMARKS:


DEPT. OF NATURAL RESOURCES
BUREAU OF LAND & WATER RESOURCES

AUG 16 1983

RECEIVED

If well telescopes please sketch and show depths.

GROUND LEVEL

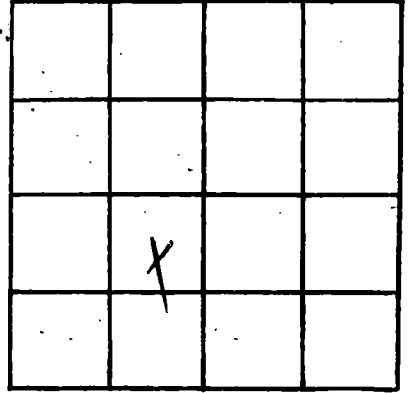

SECTION _____

Please indicate well location X.

ADDITIONAL INFORMATION

If more than one screen, show locations of each on sketch.