

MISSISSIPPI DEPARTMENT OF NATURAL RESOURCES

Bureau of Land and Water Resources

Southport Mall

P.O. Box 10631

Jackson, Mississippi 39209

WATER WELL DRILLERS LOG
COASTAL DRILLING & SERVICE CO.

ROUTE 1 BOX 618

Firm name
BILOXI, MISS. 39532

Harrison
county well located

Harrison
H
2195

4/10/83
date well completed

LANDOWNER: Sgt Braun
North River Bend Estate
Biloxi, MS
(mailing address)

description of formations encountered	from	to
Top Soil	1	3
Red Clay	3	15
Grey Sand	15	30
Soft Blue Clay	30	210
Grey water Sand	210	220
Dark Blue Clay	220	290
Grey water Sand	290	310
Dark water Sand	310	330

WELL LOCATION:

sec 36 T 6 N R 10 E
S W
Harrison Creek
(distance) (direction) (nearest town)

WELL PURPOSE:

(home, irrigation, municipal, industrial)
home

WELL COMPLETION DATA:

- (1) diameter (inches) 2"
- (2) total depth (feet) 330'
- (3) static water level (feet) 45' below top of ground.
- (4) casing PVC, 320'
(material) (depth)
(size) if telescope see back.
- (5) screen 10' length, 320' depth to top
2" size, PVC material
- (6) pump 1/2 HP, 12 yield gpm
5/8" type power
- (7) electric log no (yes or no)

(organization running log)

(8) how well bottom plugged

2" back wash valve
DRILLERS REMARKS: 19-B


DEPT. OF NATURAL RESOURCES
BUREAU OF LAND & WATER RESOURCES

AUG 16 1983

RECEIVED

If well telescopes please sketch and show depths.

GROUND LEVEL

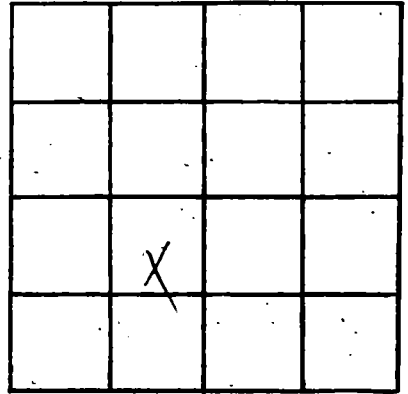

SECTION _____

Please indicate well location X.

ADDITIONAL INFORMATION

If more than one screen,
show locations of each on sketch.