

MISSISSIPPI DEPARTMENT OF NATURAL RESOURCES

Bureau of Land and Water Resources

Southport Mall

P.O. Box 10631

Jackson, Mississippi 39209

WATER WELL DRILLERS LOG

Harrison
H
2196

5/2/83 19 Lyman Well Harrison
 date well completed firm name county well located

LANDOWNER: Wayne Harrison
Rt. 2, Box 82- I4
Saucier 39574
 (mailing address)

description of formations encountered	from	to
<u>Red sand</u>	<u>0</u>	<u>20</u>
<u>red sand & clay</u>	<u>20</u>	<u>40</u>
<u>Gravel & sand</u>	<u>40</u>	<u>88</u>

WELL LOCATION:
 sec. 8 T. 6 N. R. 10 E.
5 miles SE of Saucier
 (distance) (direction) (nearest town)

WELL PURPOSE: None
 (home, irrigation, municipal, industrial)

WELL COMPLETION DATA:

(1) diameter (inches) 2"

(2) total depth (feet) 88'

(3) static water level (feet) 40 below above top of ground.

(4) casing PVC 78'
 (material) (depth)
2" if telescope see back.
 (size)

(5) screen 10' 78'
 (length) (depth to top)
2" PVC
 (size) (material)

(6) pump 1 12
 (HP) (yield gpm)
 (type power)

(7) electric log No
 (yes or no)
No
 (organization running log)

(8) how well bottom plugged sand
shark

DEPT. OF NATURAL RESOURCES
 BUREAU OF LAND & WATER RESOURCES


AUG 29 1983

RECEIVED

DRILLERS REMARKS:

If well telescopes please sketch and show depths.

GROUND LEVEL

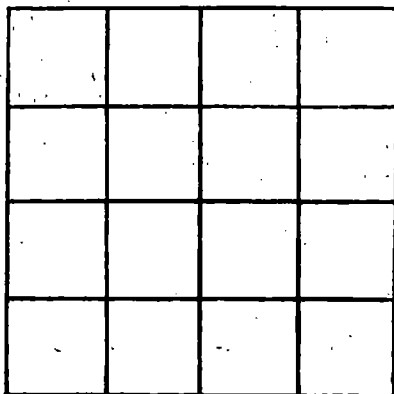

SECTION _____

Please indicate well location X.

ADDITIONAL INFORMATION

If more than one screen,
show locations of each on sketch.