

MISSISSIPPI DEPARTMENT OF NATURAL RESOURCES

Bureau of Land and Water Resources

Southport Mall

P.O. Box 10631

Jackson, Mississippi 39209

WATER WELL DRILLERS LOG

Harrison
H 2198

6/20 1983 Lyman Well Co. Harrison
 date well completed firm name county well located


LANDOWNER:	description of formations encountered	from	to
<u>Arthur Hegelus</u> <u>Rt. 5, Box 694</u> <u>Got</u> (mailing address) <u>39503</u>			
WELL LOCATION: sec. <u>21</u> T <u>6</u> N R <u>10</u> E <u>9</u> miles <u>NE</u> of <u>Got</u> (distance) (direction) (nearest town)	<u>Cravel & Clay</u>		
WELL PURPOSE: <u>ALMO</u> (home, irrigation, municipal, industrial)	<u>Blue Gumbo</u>	<u>100</u>	<u>189</u>
WELL COMPLETION DATA: (1) diameter (inches) <u>2"</u>	<u>Clay</u>		
(2) total depth (feet) <u>258</u>	<u>Fine sand</u>	<u>189</u>	<u>200</u>
(3) static water level (feet) <u>12'</u> below above top of ground.	<u>Coarse sand</u>	<u>200</u>	<u>258</u>
(4) casing <u>PVC</u> , <u>248</u> (material) (depth)			
<u>2"</u> (size) if telescope see back.			
(5) screen <u>10'</u> , <u>258</u> (length) (depth to top)			
<u>2"</u> , <u>PVC</u> (size) (material)			
(6) pump <u>1</u> , <u>12</u> (HP) (yield gpm)			
<u>elect.</u> (type power)			
(7) electric log <u>NO</u> (yes or no)			
<u>NO</u> (organization running log)			
(8) how well bottom plugged <u>Shut</u>			
DRILLERS REMARKS:			

DEPT. OF NATURAL RESOURCES
 BUREAU OF LAND & WATER RESOURCES

NOV - 3 1983
 RECEIVED

If well telescopes please sketch and show depths.

GROUND LEVEL

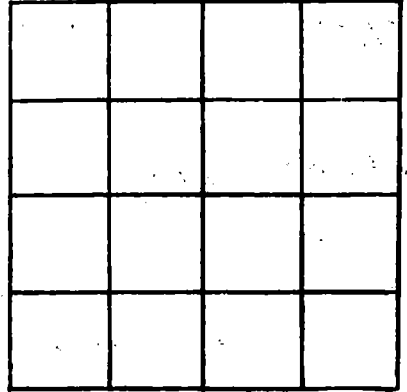

SECTION _____

Please indicate well location X.

ADDITIONAL INFORMATION

If more than one screen, show locations of each on sketch.