

MISSISSIPPI DEPARTMENT OF NATURAL RESOURCES

Bureau of Land and Water Resources

Southport Mall

P.O. Box 10631

Jackson, Mississippi 39209

WATER WELL DRILLERS LOG
COASTAL DRILLING & SERVICE, INC.

Harrison
H 2200

10/20/83 19
date well completed

ROUTE 1 BOX 618
well name

Harrison
county well located

DILON, MISS. 39532

LANDOWNER: Paul Richard
Jack Kitter Road
Biloxi, MS
(mailing address)

| description of formations encountered | from | to |
|---------------------------------------|------------|------------|
| <u>Top Soil</u> | <u>1</u> | <u>3</u> |
| <u>Red Clay</u> | <u>3</u> | <u>10</u> |
| <u>White Clay</u> | <u>10</u> | <u>25</u> |
| <u>Sandy Sand</u> | <u>25</u> | <u>40</u> |
| <u>Coarse white sand</u> | <u>40</u> | <u>65</u> |
| <u>Soft Blue Clay</u> | <u>65</u> | <u>210</u> |
| <u>Hard Blue Clay</u> | <u>210</u> | <u>290</u> |
| <u>fine grained sand</u> | <u>290</u> | <u>305</u> |
| <u>good water sand</u> | <u>305</u> | <u>325</u> |

WELL LOCATION:
see 32 T 6 N R 9 E
S W
Son Pipeline Co.
(distance) (direction) (nearest town)

WELL PURPOSE: Home
(home, irrigation, municipal, industrial)

WELL COMPLETION DATA:
(1) diameter (inches) 4 1/2"
(2) total depth (feet) 325'
(3) static water level (feet) 35' below above top of ground.
(4) casing PVC 310'
(material) (depth)
4 1/2" if telescope see back.
(size)
(5) screen 15' 310'
(length) (depth to top)
2" PVC
(size) (material)
(6) pump None 20
(HP) (yield gpm)
Ele
(type power)
(7) electric log No
(yes or no)
(organization running log)

(8) how well bottom plugged
2" backwash stake
DRILLERS REMARKS: 07-75

DEPT. OF NATURAL RESOURCES
BUREAU OF LAND & WATER RESOURCES

APR 5 1984

RECEIVED

If well telescopes please sketch and show depths.


GROUND LEVEL

160'-4" PVC
Casing

150'-2" PVC
Casing

15'-2" PVC Screen

2 backwash valves
19-B

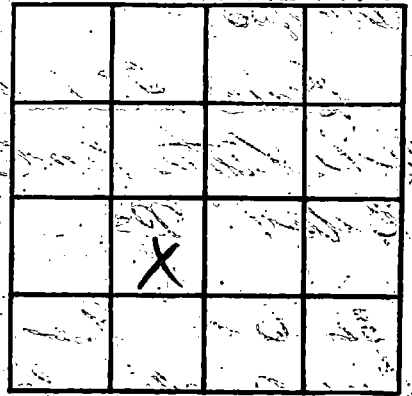

SECTION _____

Please indicate well location X.

ADDITIONAL INFORMATION

If more than one screen,
show locations of each on sketch.