

MISSISSIPPI DEPARTMENT OF NATURAL RESOURCES

Bureau of Land and Water Resources

Southport Mall

P.O. Box 10631

Jackson, Mississippi 39209

WATER WELL DRILLERS LOG

COASTAL DRILLING & SERVICE CO.

Harrison
H
2201

6/29/83
date well completed

ROUTE 1 BOX 618
firm name

Harrison
county well located

BILOXI, MISS. 39532

LANDOWNER: F. D. Sinclair
Ht 1
Biloxi, MS 39532
(mailing address)

description of formations encountered	from	to
<u>top soil</u>	<u>1</u>	<u>3</u>
<u>red clay</u>	<u>3</u>	<u>15</u>
<u>white soil</u>	<u>15</u>	<u>35</u>
<u>light blue clay</u>	<u>35</u>	<u>210</u>
<u>fine white sand</u>	<u>210</u>	<u>220</u>
<u>thick blue clay</u>	<u>220</u>	<u>300</u>
<u>good water sand</u>	<u>300</u>	<u>325</u>

WELL LOCATION:
sec 32 T 6 N R 10 E
S W
Biloxi River
(distance) (direction) (nearest town)

WELL PURPOSE: home
(home, irrigation, municipal, industrial)

WELL COMPLETION DATA:

(1) diameter (inches) 2"

(2) total depth (feet) 325'

(3) static water level (feet) 20' below above top of ground.

(4) casing PVC 305'
(material) (depth)
(size) if telescope see back.

(5) screen 10' 315'
(length) (depth to top)
2" PVC
(size) (material)

(6) pump 1100 13
(HP) (yield gpm)
Elc
(type power)

(7) electric log no
(yes or no)
(organization running log)

(8) how well bottom plugged
2" pack wash stone
DRILLERS REMARKS: 19-13


DEPT. OF NATURAL RESOURCES
BUREAU OF LAND & WATER RESOURCES

APR - 4 1984

RECEIVED

If well telescopes please sketch and show depths.

GROUND LEVEL

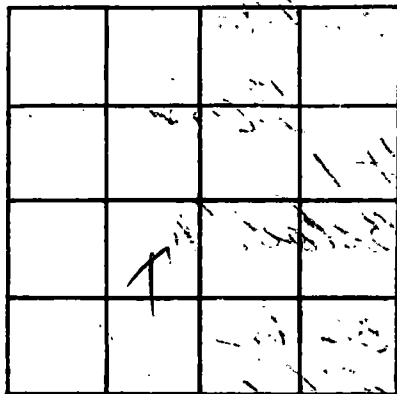

SECTION _____

Please indicate well location X.

ADDITIONAL INFORMATION

If more than one screen, show locations of each on sketch.