

MISSISSIPPI DEPARTMENT OF NATURAL RESOURCES

Bureau of Land and Water Resources

Southport Mall

P.O. Box 10631

Jackson, Mississippi 39209

WATER WELL DRILLERS LOG

COASTAL DRILLING & SERVICE CO. *Hanson*

ROUTE # BOX 618

county well located

Hanson
H
2202

date well completed 7/15/83 19

LANDOWNER W. Eyles BILOXI MISS. 39532

description of formations encountered	from	to
<u>top soil</u>	<u>1</u>	<u>3</u>
<u>red clay</u>	<u>3</u>	<u>15</u>
<u>white sand</u>	<u>15</u>	<u>40</u>
<u>soft blue clay</u>	<u>40</u>	<u>230</u>
<u>fine water sand</u>	<u>230</u>	<u>245</u>
<u>hard blue clay</u>	<u>245</u>	<u>445</u>
<u>fine water sand</u>	<u>445</u>	<u>460</u>
<u>hard water sand</u>	<u>460</u>	<u>100</u>

RT 5 Box 618A

Biloxi, MS
(mailing address)

WELL LOCATION:

sec 32 T 6 N R 10 E
Mud Creek
(distance) (direction) (nearest town)

WELL PURPOSE: home
(home, irrigation, municipal, industrial)

WELL COMPLETION DATA:

- (1) diameter (inches) 4 1/2"
- (2) total depth (feet) 500'
- (3) static water level (feet) 65' below top of ground
- (4) casing 4 1/2" (material) PC (depth) 490'
4 1/2" (size) If telescope see back.
- (5) screen 10' (length) 490' (depth to top)
2" (size) PC (material)
- (6) pump 1/2 (HP) 10 (yield gpm)
3/4 (type power)
- (7) electric log no (yes or no)

(organization running log)

(8) how well bottom plugged? 2" back wash valve
19-15

DRILLERS REMARKS:

DEPT. OF NATURAL RESOURCES
BUREAU OF LAND & WATER RESOURCES

APR - 5 1984

RECEIVED

If well telescopes please sketch and show depths.


GROUND LEVEL

2' 4" PK Casing

210' - 2" PK Casing

10' - 2" PK Screen

2" back wash Valve
19-B

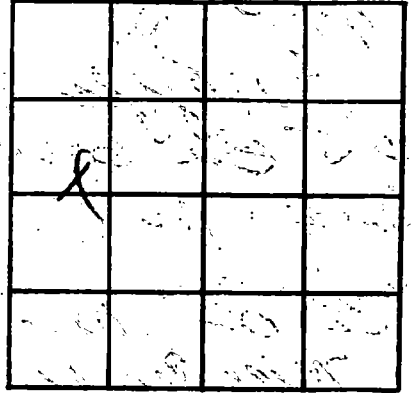

SECTION _____

Please indicate well location X.

ADDITIONAL INFORMATION

If more than one screen,
show locations of each on sketch.