

MISSISSIPPI DEPARTMENT OF NATURAL RESOURCES

Bureau of Land and Water Resources

Southport Mall

P.O. Box 10631

Jackson, Mississippi 39209

WATER WELL DRILLERS LOG

Harrison  
H  
2205

McNeil Wells Inc. Harrison

2-1-84 date well completed

firm name

county well located

LANDOWNER: Glean Mitchell

Description of formations encountered

from

to

Mayer

Long Beach Ms. 39560  
 (mailing address)

<u>Sand</u>	<u>0</u>	<u>20</u>
<u>Mud</u>	<u>20</u>	<u>200</u>
<u>f. Sand</u>	<u>200</u>	<u>250</u>
<u>course Sand</u>	<u>250</u>	<u>280</u>

WELL LOCATION:

sec. 32 T. 6 N. R. 10 E  
4 miles E of Workmarket  
 (distance) (direction) (nearest town)

WELL PURPOSE: none  
 (home, irrigation, municipal, industrial)

WELL COMPLETION DATA:

- (1) diameter (inches) 2"
- (2) total depth (feet) 280'
- (3) static water level (feet) 10' ~~below~~ above top of ground.
- (4) casing PVC; 270  
 (material); (depth)  
 (size) if telescope see back.
- (5) screen 10'; 270  
 (length); (depth to top)  
2"; Sch. 80 PVC  
 (size); (material)
- (6) pump 1/2; 8  
 (HP); (yield gpm)  
electric  
 (type power)
- (7) electric log no  
 (yes or no)

(organization running log)

(8) how well bottom plugged grd seal

DEPT. OF NATURAL RESOURCES  
 BUREAU OF LAND & WATER RESOURCES


APR - 5 1984

RECEIVE

DRILLERS REMARKS:

If well telescopes please sketch and show depths.

GROUND LEVEL

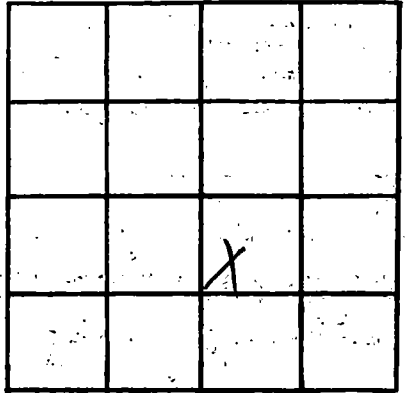

SECTION 32

Please indicate well location X.

ADDITIONAL INFORMATION

If more than one screen, show locations of each on sketch.