

**MISSISSIPPI DEPARTMENT OF NATURAL RESOURCES**  
**Bureau of Land and Water Resources**  
 Southport Mall  
 P.O. Box 10631  
 Jackson, Mississippi 39209  
**WATER WELL DRILLERS LOG**

Harrison  
H  
2206

5/22/84 19 Mc Deep Well Works Harrison  
 date well completed firm name county well located

LANDOWNER: Greelan Clark  
200 Rich Ave  
Biloxi, Ms.  
 (mailing address)

description of formations encountered	from	to
	<u>Sand</u>	<u>0</u>

WELL LOCATION:  
 sec 32 T. 16 N R. 10 E  
3 miles N of Biloxi  
 (distance) (direction) (nearest town)

WELL PURPOSE: home use  
 (home, irrigation, municipal, industrial)

WELL COMPLETION DATA:

(1) diameter (inches) 2"

(2) total depth (feet) 30'

(3) static water level (feet) \_\_\_\_\_ below above top of ground.

(4) casing sch 40 20'  
 (material) (depth)  
 (size) if telescope see back.

(5) screen 10' 20'  
 (length) (depth to top)  
2" sch 80  
 (size) (material)

(6) pump 1/2 \_\_\_\_\_  
 (HP) (yield gpm)  
elec.  
 (type power)

(7) electric log \_\_\_\_\_  
 (yes or no)  
 (organization running log)

(8) how well bottom plugged cap

DRILLERS REMARKS:


DEPT. OF NATURAL RESOURCES  
 BUREAU OF LAND & WATER RESOURCES

JUN - 1 1984

**RECEIVED**

If well telescopes please sketch and show depths.

GROUND LEVEL

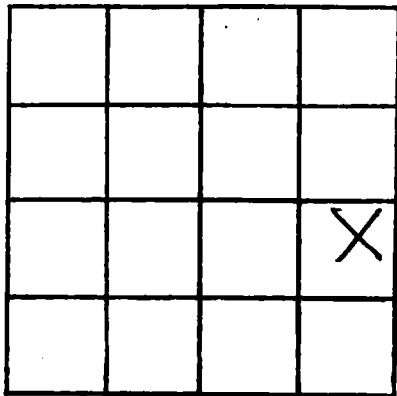

SECTION \_\_\_\_\_

Please indicate well location X.

ADDITIONAL INFORMATION

If more than one screen, show locations of each on sketch.