

MISSISSIPPI DEPARTMENT OF NATURAL RESOURCES

Bureau of Land and Water Resources

Southport Mall

P.O. Box 10631

Jackson, Mississippi 39209

WATER WELL DRILLERS LOG  
COASTAL DRILLING & SERVICE CO.

ROUTE 1 BOX 618

BILOXI MISS. 39532

*Harris*  
county well located

*Harris*  
*H*  
*2208*

7/19/83 19  
date well completed

LANDOWNER: *Stagell*

description of formations encountered

from to

*Rt 6 Box*

*Biloxi Drms*  
(mailing address)

<i>top soil</i>	<i>1</i>	<i>3</i>
<i>Red Clay</i>	<i>3</i>	<i>18</i>
<i>Coarse white sand</i>	<i>18</i>	<i>60</i>
<i>Soft Blue Clay</i>	<i>60</i>	<i>225</i>
<i>hard blue clay</i>	<i>275</i>	<i>410</i>
<i>fine white sand</i>	<i>410</i>	<i>425</i>
<i>hard blue clay</i>	<i>425</i>	<i>640</i>
<i>8th water table</i>	<i>640</i>	<i>687</i>

WELL LOCATION:

sec *33* T. *6* N. R. *10* E  
S W  
*(Wore North Woodmark)*  
(distance) (direction) (nearest town)

WELL PURPOSE: *home*  
(home, irrigation, municipal, industrial)


WELL COMPLETION DATA:

- (1) diameter (inches) *2"*
- (2) total depth (feet) *687'*
- (3) static water level (feet) *40* below above top of ground.
- (4) casing *PVC* *677'*  
(material) (depth)
- (size) if telescope see back.
- (5) screen *10'* *677'*  
(length) (depth to top)
- 2"* *PVC*  
(size) (material)
- (6) pump *1/2* *12*  
(HP) (yield gpm)
- 5/8"*  
(type power)
- (7) electric log *no*  
(yes or no)

(organization running log)

(8) how well bottom plugged *2" backwash valve*

DRILLERS REMARKS: *19-B*

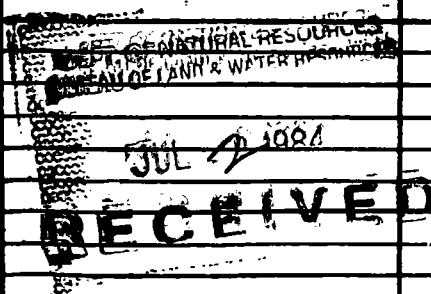

If well telescopes please sketch and show depths.

GROUND LEVEL

	X		

SECTION \_\_\_\_\_

Please indicate well location X.

ADDITIONAL INFORMATION

If more than one screen, show locations of each on sketch.