

MISSISSIPPI DEPARTMENT OF NATURAL RESOURCES

Bureau of Land and Water Resources

Southport Mall

P.O. Box 10631

Jackson, Mississippi 39209

WATER WELL DRILLERS LOG
COASTAL DRILLING & SERVICE CO.

ROUTE 1 BOX 618

BILOXI MISS. 39532

Harrison
H
2209

9/2/83 19
date well completed

Harrison
county well located

LANDOWNER: *Clint Wilson*

description of formations encountered

from to

RT-5
Biloxi MS
(mailing address)

<i>top soil</i>	<i>1</i>	<i>3</i>
<i>red clay</i>	<i>3</i>	<i>15</i>
<i>white sand</i>	<i>15</i>	<i>30</i>
<i>soft blue clay</i>	<i>30</i>	<i>145</i>
<i>hard blue clay</i>	<i>145</i>	<i>165</i>
<i>fine water sand</i>	<i>165</i>	<i>180</i>
<i>coarse water sand</i>	<i>180</i>	<i>200</i>

WELL LOCATION:

sec. *19* T. *6* N. R. *9* E.
S. W.
(3) three miles North of Lake
(distance) (direction) (nearest town)

WELL PURPOSE:

(home, irrigation, municipal, industrial)

WELL COMPLETION DATA:

- (1) diameter (inches) *2"*
- (2) total depth (feet) *200'*
- (3) static water level (feet) *32'* below above top of ground.
- (4) casing *PLC* *190'*
(material) (depth)
- (size) If telescope see back.
- (5) screen *10'* *190'*
(length) (depth to top)
- 2"* *PLC*
(size) (material)
- (6) pump *None* *12*
(HP) (yield gpm)
- ELC*
(type power)
- (7) electric log *No*
(yes or no)

(organization running log)

(8) how well bottom plugged
2' hard water value

DRILLERS REMARKS: *19-B*


DEPT. OF NATURAL RESOURCES
BUREAU OF LAND & WATER RESOURCES

JUN 28 1984

RECEIVED

If well telescopes please sketch and show depths.

GROUND LEVEL

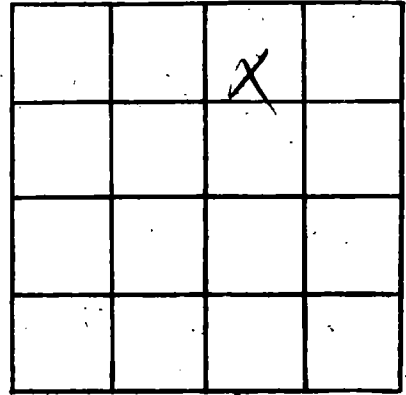

SECTION _____

Please indicate well location X.

ADDITIONAL INFORMATION

If more than one screen, show locations of each on sketch.