

MISSISSIPPI DEPARTMENT OF NATURAL RESOURCES

Bureau of Land and Water Resources

Southport Mall

P.O. Box 10631

Jackson, Mississippi 39209

WATER WELL DRILLERS LOG
COASTAL DRILLING & SERVICE CO.

Harrison
H
2216

10/20/83 19
date well completed

ROUTE 1 BOX 618
firm name

Harrison
county well located

BILOXI, MISS. 39532

LANDOWNER: Structure Lake

description of formations encountered

from to

15708 Indigo Dr
Biloxi, MS
(mailing address)

<u>Top Soil</u>	<u>1</u>	<u>3</u>
<u>Red Clay</u>	<u>3</u>	<u>15</u>
<u>Coarse white sand</u>	<u>15</u>	<u>35</u>
<u>Silt. sand</u>	<u>35</u>	<u>60</u>
<u>Soft blue clay</u>	<u>60</u>	<u>210</u>
<u>Hard blue clay</u>	<u>210</u>	<u>265</u>
<u>fine water sand</u>	<u>265</u>	<u>300</u>
<u>good water sand</u>	<u>300</u>	<u>320</u>

WELL LOCATION:

sec 32 T. 6 N R. 9 E
S W
for line & power line
(distance) miles (direction) (nearest town)

WELL PURPOSE: home
(home, irrigation, municipal, industrial)

WELL COMPLETION DATA:

- (1) diameter (inches) 2"
- (2) total depth (feet) 320'
- (3) static water level (feet) 46' below above-top of ground.
- (4) casing PVC 310'
(material) (depth)
- (size) If telescope see back.
- (5) screen 10' 310'
(length) (depth to top)
- 2" PVC
(size) (material)
- (6) pump None 12
(HP) (yield gpm)
- 1/2
(type power)
- (7) electric log No
(yes or no)

(organization running log)

(8) how well bottom plugged
Dr Jack White

DRILLERS REMARKS:


MISSISSIPPI DEPARTMENT OF NATURAL RESOURCES
BUREAU OF LAND & WATER RESOURCES

JUN 28 1984

RECEIVED

If well telescopes please sketch and show depths.

GROUND LEVEL

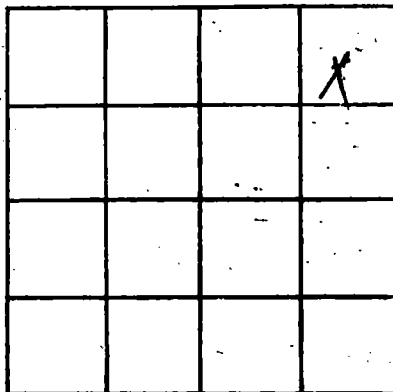

SECTION _____

Please indicate well location X.

ADDITIONAL INFORMATION

If more than one screen,
show locations of each on sketch.