

MISSISSIPPI DEPARTMENT OF NATURAL RESOURCES

Bureau of Land and Water Resources

Southport Mall

P.O. Box 10631

Jackson, Mississippi 39209

WATER WELL DRILLERS LOG
COASTAL DRILLING & SERVICE CO.

ROUTE 1 BOX 618

firm name
BILOXI MISS. 39532

county well located

Harrison
H
2217

10/23/83 19
date well completed

Harrison
county well located

LANDOWNER	description of formations encountered	from	to
<u>Mike Ramsey</u>	<u>top soil</u>	<u>1</u>	<u>3</u>
<u>2433rd Ave</u>	<u>Red Clay</u>	<u>3</u>	<u>15</u>
<u>N. Biloxi Ferry Bridge</u> (mailing address)	<u>Coarse white sand</u>	<u>15</u>	<u>30</u>
	<u>Sp. Blue Clay</u>	<u>30</u>	<u>210</u>
	<u>fine water sand</u>	<u>210</u>	<u>230</u>
	<u>Red Blue Clay</u>	<u>230</u>	<u>280</u>
	<u>good water sand</u>	<u>280</u>	<u>300</u>

WELL LOCATION:
sec 33 T 6 N R 9 E
S W
Mississippi Col line
(distance) (direction) of (nearest town)

WELL PURPOSE: home
(home, irrigation, municipal, industrial)

WELL COMPLETION DATA:

(1) diameter (inches) 2"

(2) total depth (feet) 300'

(3) static water level (feet) 30 below above top of ground.

(4) casing PVC 290'
(material) (depth)
(size) if telescope see back.

(5) screen 10' 290'
(length) (depth to top)
2" PVC
(size) (material)

(6) pump 1/2 12
(HP) (yield gpm)
Ele
(type power)

(7) electric log no
(yes or no)

(organization running log)

(8) how well bottom plugged
2" back wash valves
DRILLERS REMARKS: 19-13


DEPT OF NATURAL RESOURCES
BUREAU OF LAND & WATER RESOURCES

JUL - 2 1984

RECEIVED

If well telescopes please sketch and show depths.

GROUND LEVEL

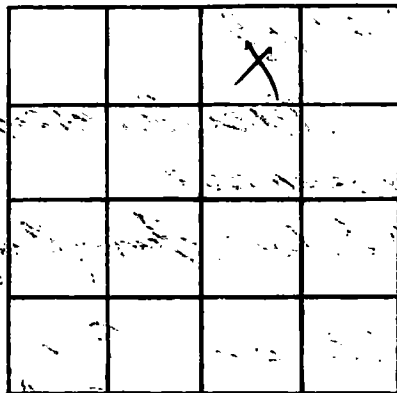

SECTION _____

Please indicate well location X.

ADDITIONAL INFORMATION

If more than one screen, show locations of each on sketch.