

HARRISON
H
2221

MISSISSIPPI DEPARTMENT OF NATURAL RESOURCES
Bureau of Land and Water Resources
Southport Mall
P.O. Box 10631
Jackson, Mississippi 39209
WATER WELL DRILLERS LOG

5/28/84 19 McMill Well Works Harrison
date well completed firm name county well located

LANDOWNER: Maurice Litch
1150 E Howard
Belzli, Mo.
(mailing address)

description of formations encountered	from	to
Sand	0	20
clay	20	280
gravel sand	280	300
sand	300	320

WELL LOCATION:
sec 32 T 6 N R 10 E
2 miles S of Belzli
(distance) (direction) (nearest town)

WELL PURPOSE: home
(home, irrigation, municipal, industrial)

- WELL COMPLETION DATA:
- (1) diameter (inches) 2"
 - (2) total depth (feet) 320'
 - (3) static water level (feet) 100 below top of ground
 - (4) casing 4" sch 40 pipe, 310' (material) (depth)
(size) If telescope see back.
 - (5) screen 10' 310' (length) (depth to top)
2" sch 80 (size) (material)
 - (6) pump 1 (HP) 8 (yield gpm)
elec (type power)
 - (7) electric log (yes or no)
 - (organization running log)
 - (8) how well bottom plugged sand seal

DEPT. OF NATURAL RESOURCES
BUREAU OF LAND & WATER RESOURCES


MAY 10 1984

RECEIVED

DRILLERS REMARKS:

If well telescopes please sketch and show depths.

GROUND LEVEL

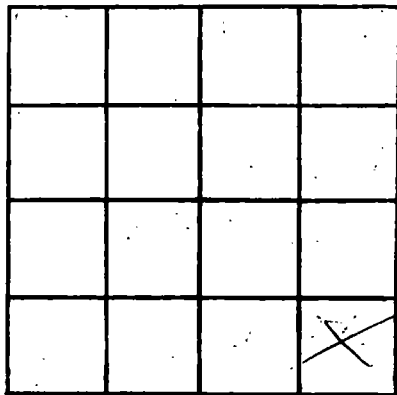

SECTION 32

Please indicate well location X.

ADDITIONAL INFORMATION

If more than one screen, show locations of each on sketch.