

MISSISSIPPI DEPARTMENT OF NATURAL RESOURCES
Bureau of Land and Water Resources
 Southport Mall
 P.O. Box 10631
 Jackson, Mississippi 39209
WATER WELL DRILLERS LOG

Harrison
H
2223

7-6-84 1984 Yme Geo Well Works Harrison
 date well completed firm name county well located

LANDOWNER: John Jorick
6612 Holzstock Rd
Biloxi, Miss.
 (mailing address)

description of formations encountered	from	to
	<u>clay</u>	<u>0</u>
<u>mucl sand</u>	<u>20</u>	<u>340</u>
<u>DAND</u>	<u>380</u>	<u>430</u>

WELL LOCATION:
 sec 32 T. 6 N R. 10 E
2 miles SW of Biloxi
 (distance) (direction) (nearest town)

WELL PURPOSE:
 (home, irrigation, municipal, industrial)

WELL COMPLETION DATA:

(1) diameter (inches) 2"

(2) total depth (feet) 430'

(3) static water level (feet) 25 ^{below} _{above} top of ground.

(4) casing sch 40 PVC 420'
 (material) (depth)

 If telescope see back.
 (size)

(5) screen 10' 430'
 (length) (depth to top)

2" sch 80 basket
 (size) (material)

(6) pump 1 8
 (HP) (yield gpm)

elec
 (type power)

(7) electric log
 (yes or no)

 (organization running log)

(8) how well bottom plugged hal

DRILLERS REMARKS:


DEPT. OF NATURAL RESOURCES
 BUREAU OF LAND & WATER RESOURCES

AUG 13 1984

RECEIVED

If well telescopes please
sketch and show depths.

GROUND LEVEL

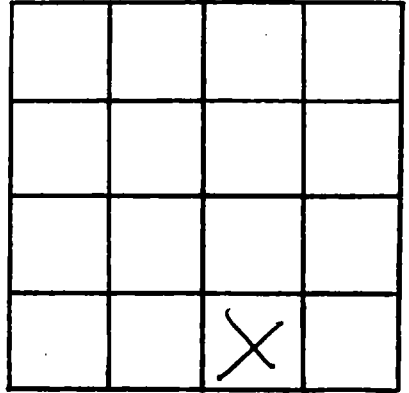

SECTION _____

Please indicate well location X.

ADDITIONAL INFORMATION

If more than one screen,
show locations of each on sketch.