

MISSISSIPPI DEPARTMENT OF NATURAL RESOURCES
Bureau of Land and Water Resources
 Southport Mall
 P.O. Box 10631
 Jackson, Mississippi 39209
WATER WELL DRILLERS LOG

Harrison
H
2224


7-12-84 19 McMill Well Works Harrison
 date well completed firm name county well located

LANDOWNER: <u>Northrup</u>	description of formations encountered	from	to
<u>Long Beach</u> (mailing address)			
WELL LOCATION: sec. <u>32</u> T. <u>6</u> N. R. <u>10</u> E	<u>mud & sand</u>	<u>20</u>	<u>40</u>
<u>4</u> miles <u>NE</u> of <u>Luport</u> (distance) (direction) (nearest town)	<u>mud</u>	<u>110</u>	<u>140</u>
WELL PURPOSE: (home, irrigation, municipal, industrial)	<u>sand</u>	<u>140</u>	<u>180</u>
WELL COMPLETION DATA:			
(1) diameter (inches) <u>2"</u>			
(2) total depth (feet) <u>180'</u>			
(3) static water level (feet) <u>25'</u> ^{below} top of ground.			
(4) casing <u>sch 40 PVC</u> <u>170'</u> (material) (depth)			
(size) If telescope see back.			
(5) screen <u>10'</u> <u>170'</u> (length) (depth to top)			
<u>2"</u> <u>sch 80</u> <u>6 slot</u> (size) (material)			
(6) pump <u>1</u> <u>✓</u> (HP) (yield gpm)			
<u>elec</u> (type power)			
(7) electric log _____ (yes or no)			
_____ (organization running log)			
(8) how well bottom plugged <u>Seal</u>			
DRILLERS REMARKS:			

DEPT. OF NATURAL RESOURCES
 BUREAU OF LAND & WATER RESOURCES
 AUG 13 1984
RECEIVED

If well telescopes please
sketch and show depths.

GROUND LEVEL

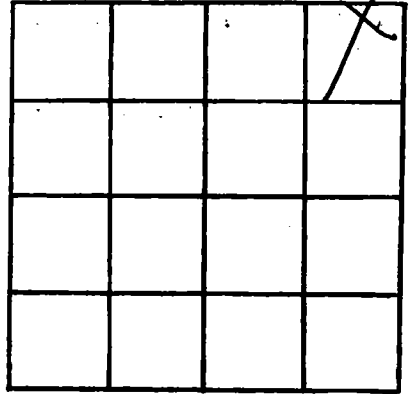

SECTION _____

Please indicate well location X.

ADDITIONAL INFORMATION

If more than one screen,
show locations of each on sketch.