

MISSISSIPPI DEPARTMENT OF NATURAL RESOURCES  
 Bureau of Land and Water Resources  
 Southport Mall  
 P.O. Box 10631  
 Jackson, Mississippi 39209  
**WATER WELL DRILLERS LOG**

Harrison  
H  
2225

7-18-84 19 McNeil Wells Harrison  
 date well completed firm name county well located

LANDOWNER: Myrtle Lechner  
213 Rich Ave.  
Biloxi, Mo.  
 (mailing address)

Description of formations encountered	from to	
<u>sand</u>	<u>0</u>	<u>30</u>

WELL LOCATION:  
 sec 32 T 16 N R 10 E  
2 miles S of Bix  
 (distance) (direction) (nearest town)

WELL PURPOSE:  
 (home, irrigation, municipal, industrial)

WELL COMPLETION DATA:

(1) diameter (inches) 2"

(2) total depth (feet) 30'

(3) static water level (feet) 10 <sup>below</sup> ~~above~~ top of ground.

(4) casing sch 40 PVC 30'  
 (material) (depth)  
 (size) if telescope see back.

(5) screen 10' 20'  
 (length) (depth to top)  
2" sch 40 black  
 (size) (material)

(6) pump 1/2 15  
 (HP) (yield gpm)  
elec  
 (type power)

(7) electric log                       
 (yes or no)  
                      
 (organization running log)


(8) how well bottom plugged Seal

DRILLERS REMARKS:

DEPT. OF NATURAL RESOURCES  
 BUREAU OF LAND & WATER RESOURCES  
 AUG 13 1984  
**RECEIVED**

If well telescopes please sketch and show depths.

GROUND LEVEL

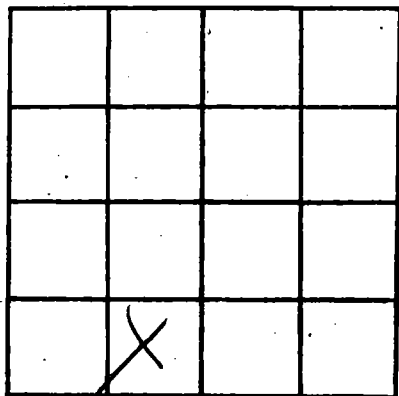

SECTION \_\_\_\_\_

Please indicate well location X.

ADDITIONAL INFORMATION

If more than one screen, show locations of each on sketch.