

MISSISSIPPI DEPARTMENT OF NATURAL RESOURCES

Bureau of Land and Water Resources

Southport Mall

P.O. Box 10631

Jackson, Mississippi 39209

WATER WELL DRILLERS LOG

Harrison  
H  
2228

9/10 1984 Broderburg <sup>Sen. Inc.</sup> Well Harrison  
 date well completed name county well located

LANDOWNER	description of formations encountered	from	to
<u>Richard Drafly Jr.</u> <u>Rt. 2 Box 314A</u>	<u>Clay</u>	<u>0</u>	<u>20</u>
<u>N. Biloyi Ma 39532</u> (mailing address)	<u>sand</u>	<u>20</u>	<u>80</u>
	<u>Clay</u>	<u>80</u>	<u>190</u>
	<u>sand</u>	<u>190</u>	<u>200</u>
	<u>Clay</u>	<u>200</u>	<u>290</u>
	<u>sand</u>	<u>290</u>	<u>320</u>

WELL LOCATION:  
 sec. 25 T. 6 R. 10  
5 miles East of Woodmarket  
 (distance) (direction) (nearest town)

WELL PURPOSE: Home  
 (home, irrigation, municipal, industrial)

WELL COMPLETION DATA:

(1) diameter (inches) 2"

(2) total depth (feet) 320'

(3) static water level (feet) 45 below top of ground.

(4) casing PVC 310'  
 (material) (depth)

2" if telescope see back.  
 (size)

(5) screen 10' 310  
 (length) (depth to top)

2" PVC underbar  
 (size) (material)

(6) pump 1 5  
 (HP) (yield gpm)

230V  
 (type power)

(7) electric log no  
 (yes or no)

(organization running log)

(8) how well bottom plugged PVC  
hardshank

DRILLERS REMARKS: no  
tailpipe


DEPT. OF NATURAL RESOURCES  
 BUREAU OF LAND & WATER RESOURCES

OCT 26 1984

RECEIVED

If well telescopes please sketch and show depths.

GROUND LEVEL

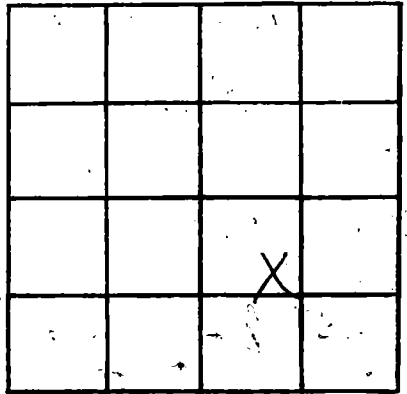

SECTION 25

Please indicate well location X.

ADDITIONAL INFORMATION

If more than one screen, show locations of each on sketch.