

MISSISSIPPI DEPARTMENT OF NATURAL RESOURCES

Bureau of Land and Water Resources

Southport Mall

P.O. Box 10631

Jackson, Mississippi 39209

WATER WELL DRILLERS LOG  
COASTAL DRILLING & SERVICE CO.

Hanson  
H  
2229

2/4/84 19  
date well completed

ROUTE 1 BOX 618  
firm name

Hanson  
county well located

BILOXI MISS. 39532

LANDOWNER Henry Pungo

description of formations encountered

from to

P.O. Box A H  
Bidoti Gas  
(mailing address)

<u>Top Soil</u>	<u>1</u>	<u>3</u>
<u>Red Clay</u>	<u>3</u>	<u>15</u>
<u>Coarse white sand</u>	<u>15</u>	<u>30</u>
<u>Soft Blue Clay</u>	<u>30</u>	<u>110</u>
<u>hard Blue Clay</u>	<u>110</u>	<u>250</u>
<u>good water sand</u>	<u>250</u>	<u>270</u>

WELL LOCATION:

sec 32 T 10 N R 10 E  
S W  
Woodport Lake  
(distance) miles (direction) of (nearest town)

WELL PURPOSE:

(home, irrigation, municipal, industrial)

WELL COMPLETION DATA:

- (1) diameter (inches) 2"
- (2) total depth (feet) 270'
- (3) static water level (feet) 10' below above top of ground.
- (4) casing PVC 260'  
(material) (depth)
- 2"  
(size) if telescope see back.
- (5) screen 10' 260'  
(length) (depth to top)
- 2" PVC  
(size) (material)
- (6) pump 1/2 10  
(HP) (yield gpm)
- ele  
(type power)
- (7) electric log no  
(yes or no)

(organization running log)

DEPT. OF NATURAL RESOURCES  
BUREAU OF LAND & WATER RESOURCES


NOV 16 1984

RECEIVED

(8) how well bottom plugged  
2' sand with valve  
DRILLERS REMARKS:

If well telescopes please sketch and show depths.

GROUND LEVEL

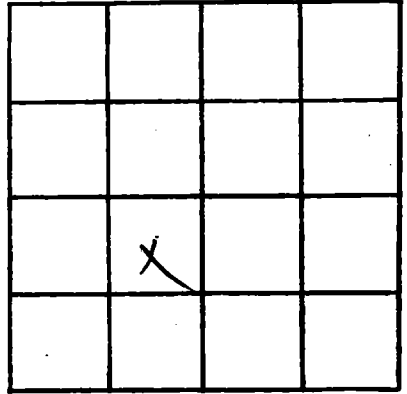

SECTION \_\_\_\_\_

Please indicate well location X.

ADDITIONAL INFORMATION

If more than one screen, show locations of each on sketch.