

MISSISSIPPI DEPARTMENT OF NATURAL RESOURCES

Bureau of Land and Water Resources

Southport Mall

P.O. Box 10631

Jackson, Mississippi 39209

**WATER WELL DRILLERS LOG**  
**COASTAL DRILLING & SERVICE CO.**

Harrison  
~~E~~ ~~H~~ 2230  
 5-26-84  
~~2230~~

5/26/84 19  
 date well completed

DT. 11, FOX 01  
 firm name

HARRISON  
 county well located

BILOXI, MS 39532

LANDOWNER: Riley Sanders

description of formations encountered

from to

Denaine Rd.

top soil

1 3

Biloxi, MS

(mailing address)

red clay

3 20

WELL LOCATION:

sec. 5 T. 6 N. R. 10 E  
 S W

sugar sand

20 45

Denaine Rd.

(distance) (direction) (nearest town)

soft blue clay

45 165

WELL PURPOSE:

(home, irrigation, municipal, industrial)

home

hard blue clay

165 280

WELL COMPLETION DATA:

(1) diameter (inches) 4" x 2"

(2) total depth (feet) 540

(3) static water level (feet) 20 below above top of ground.

(4) casing PVC, 520,  
 (material) (depth)

4" x 2" if telescope see back.  
 (size)

(5) screen 20', 520  
 (length) (depth to top)

2", PVC  
 (size) (material)

(6) pump 1, 179  
 (HP) (yield gpm)

ELC  
 (type power)

(7) electric log NO  
 (yes or no)

(organization running log)

(8) how well bottom plugged 2" back wash valve 19-B

course white sand

280 310

sugar sand

310 330

soft blue clay

330 420

hard blue clay

420 520

fine water sand

520 530

coarse water sand

530 540

DRILLERS REMARKS:

**RECEIVED**

JUL 22 1985

If well telescopes please sketch and show depths.

GROUND LEVEL


240' 4" pvc casing

300' 2" pvc casing

20' 2" pvc screen

2" back wash valve

If more than one screen, show locations of each on sketch.

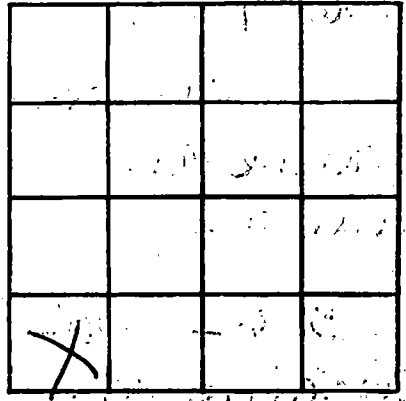

SECTION \_\_\_\_\_

Please indicate well location X.

ADDITIONAL INFORMATION

Multiple horizontal lines for additional information.