

MISSISSIPPI DEPARTMENT OF NATURAL RESOURCES

Bureau of Land and Water Resources

Southport Mall

P.O. Box 10631

Jackson, Mississippi 39209

WATER WELL DRILLERS LOG  
COASTAL DRILLING & SERVICE CO.

ROUTE 1 BOX 618

firm name  
BILOXI, MISS. 39537

HARRISON  
county well located

Harrison  
# H 2233  
7-2-84

7/2/84

date well completed

LANDOWNER: Fred Fayard

WOOD MARKET

BILOXI, MISS

(mailing address)

WELL LOCATION:

sec. 4 T. 6-N R. 10-E  
S W

WOOD MARKET

(distance) (direction) (nearest town)

WELL PURPOSE:

(home, irrigation, municipal, industrial)

WELL COMPLETION DATA:

- (1) diameter (inches) 4 1/2"
- (2) total depth (feet) 200'
- (3) static water level (feet) 185' below ~~surface~~ top of ground.
- (4) casing PVC, 185', (material) (depth)  
4 1/2" (size) If telescope see back.
- (5) screen 15', 185' (length) (depth to top)  
2" (size) PVC (material)
- (6) pump 1 (HP) 17 (yield gpm)  
E/C (type power)
- (7) electric log NO (yes or no)

(organization running log)

(8) how well bottom plugged 2" back-  
WASH VALVE 1A-B

DRILLERS REMARKS:

description of formations encountered

	from	to
top soil	1	3
RED CLAY	3	15
COURSE WHITESAND	15	45
SOFT BLUE CLAY	45	120
SUGAR SAND	120	140
HARD BLUE CLAY	140	180
FINE WATER SAND	180	190
GOOD WATER SAND	190	200

RECEIVED  
JUL 22 1985

Department of Natural Resources  
Bureau of Land & Water Resources

If well telescopes please sketch and show depths.


GROUND LEVEL

62' 4" PVC casing

63' 2" PVC casing

15' 2" PVC screen

2" backwash valve 19-B

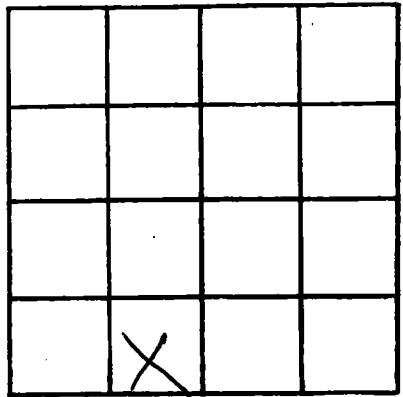

SECTION \_\_\_\_\_

Please indicate well location X.

ADDITIONAL INFORMATION

If more than one screen, show locations of each on sketch.