

MISSISSIPPI DEPARTMENT OF NATURAL RESOURCES

Bureau of Land and Water Resources

Southport Mall

P.O. Box 10631

Jackson, Mississippi 39209

WATER WELL DRILLERS LOG

COASTAL DRILLING & SERVICE CO.

Harrison
H
2234

8/21/84

date well completed

RT. #1 BOX 81

BILOXI, MS 39532

Harrison
county well located

LANDOWNER: Dr. Munderson

2301 Daisy Westwood Rd.

Biloxi, MS

(mailing address)

WELL LOCATION:

sec. 13 T 6 N R 9 E S W

Biloxi miles of (distance) (direction) (nearest town)

WELL PURPOSE: home
(home, irrigation, municipal, industrial)

WELL COMPLETION DATA:

- (1) diameter (inches) 4" x 2"
- (2) total depth (feet) 600
- (3) static water level (feet) 15 below top of ground.
- (4) casing PVC, 585 (material), (depth)
4" x 2" (size) If telescope see back.
- (5) screen 15', 585 (length), (depth to top)
2" (size), PVC (material)
- (6) pump 1 (HP), 17 (yield gpm)
etc. (type power)
- (7) electric log NO (yes or no)

(organization running log)

(8) how well bottom plugged 3" back wash valve. 19-B

DRILLERS REMARKS:

description of formations encountered	from to	
top soil	1	5
sugar sand	5	25
red clay	25	150
soft blue clay	150	260
hard blue clay	260	380
course white sand	380	410
hard blue clay	410	570
fine water sand	570	590
good water sand	590	600

RECEIVED

FEB 18 1986

Department of Natural Resources
Bureau of Land & Water Resources

If well telescopes please sketch and show depths.


GROUND LEVEL

160' 4" pvc casing

440' 2" pvc casing

15' 2" pvc screen

3" back wash valve

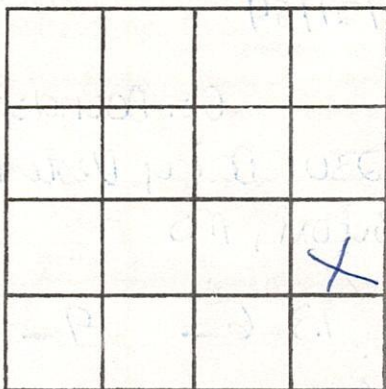

SECTION _____

Please indicate well location X.

ADDITIONAL INFORMATION

If more than one screen, show locations of each on sketch.