

MISSISSIPPI DEPARTMENT OF NATURAL RESOURCES

Bureau of Land and Water Resources

Southport Mall

P.O. Box 10631

Jackson, Mississippi 39209

WATER WELL DRILLERS LOG
COASTAL DRILLING & SERVICE CO.

Amerson
H
2236

8/21/84

date well completed

RT. 11 BOX 81
firm name

Stanton
county well located

BILOXI, MS 39532

LANDOWNER: JOHN COSSO

Daisy Wingo Rd.

Biloxi, MS

(mailing address)

WELL LOCATION:

sec. 10 T. 6 N. R. 10 E.
S W

Biloxi

miles of (distance) (direction) of (nearest town)

WELL PURPOSE: HOME

(home, irrigation, municipal, industrial)

WELL COMPLETION DATA:

- (1) diameter (inches) 2"
- (2) total depth (feet) 250'
- (3) static water level (feet) 10 below above top of ground.
- (4) casing pvc, 240,
(material) (depth)
(size) If telescope see back.
- (5) screen 10', 240'
(length) (depth to top)
2" pvc
(size) (material)
- (6) pump 1 17
(HP) (yield gpm)
etc.
(type power)
- (7) electric log NO
(yes or no)

(organization running log)

(8) how well bottom plugged 2" back washable.

DRILLERS REMARKS: None


description of formations encountered	from	to
top soil	1	3
red clay	3	140
super sand	140	170
hard blue clay	170	230
fine water sand	230	240
good water sand	240	250

RECEIVED
FEB 13 1986

Department of Natural Resources
Bureau of Land and Water Resources

If well telescopes please sketch and show depths.

GROUND LEVEL

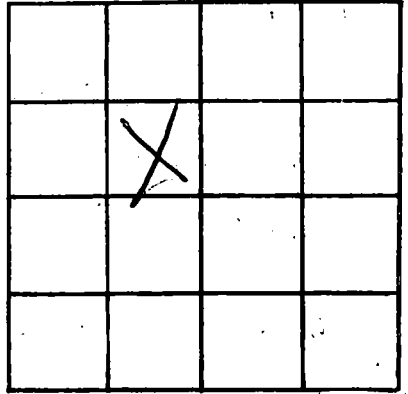

SECTION _____

Please indicate well location X.

ADDITIONAL INFORMATION

If more than one screen, show locations of each on sketch.