

MISSISSIPPI DEPARTMENT OF NATURAL RESOURCES

Bureau of Land and Water Resources

Southport Mall

P.O. Box 10631

Jackson, Mississippi 39209

WATER WELL DRILLERS LOG

COASTAL DRILLING & SERVICE CO.

Jackson
H
2242

Sept 27, 85 19  
date well completed

RT. 21, BOX 85

Jackson county well located

LANDOWNER: John Ellis  
RT. 21 BOX 85  
Biloxi, MS 39532  
(mailing address)

Description of formations encountered.	from	to
top soil	1	10
red clay	10	30
hard blue clay	30	180
soft blue clay	180	365
red clay	365	480
fine water sand	480	490
good water sand	490	500

WELL LOCATION:  
sec. 31 T 6 N R 10 E  
S W  
Woodmarket  
miles of (distance) (direction) (nearest town)

WELL PURPOSE: home  
(home, irrigation, municipal, industrial)

WELL COMPLETION DATA:

(1) diameter (inches) 2"  
(2) total depth (feet) 500  
(3) static water level (feet) 10 below top of ground.  
(4) casing PVC, 490 (material) (depth)  
(size) If telescope see back.  
(5) screen 10', 490 (length) (depth to top)  
2" PVC (size) (material)  
(6) pump 1 (HP) 9 (yield gpm)  
Etc (type power)  
(7) electric log No (yes or no)  
(organization running log)  
(8) how well bottom plugged 2" back wash valve.


DRILLERS REMARKS:

RECEIVED  
FEB 14 1986

Department of Natural Resources  
Bureau of Land & Water Resources

If well telescopes please sketch and show depths.

GROUND LEVEL

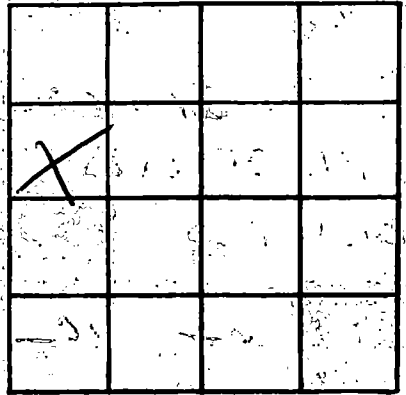

SECTION \_\_\_\_\_

Please indicate well location X:

ADDITIONAL INFORMATION

If more than one screen, show locations of each on sketch.