

MISSISSIPPI DEPARTMENT OF NATURAL RESOURCES

Bureau of Land and Water Resources

Southport Mall

P.O. Box 10631

Jackson, Mississippi 39209

WATER WELL DRILLERS LOG

COASTAL DRILLING & SERVICE CO.

Harrison
H
2244

NOV 5 1984
date well completed

RT. 11 BOX 81

Harrison
county well located

Belzoni, MS 39532

LANDOWNER: Ray Sturman

description of formations encountered

from to

Rt. 3 Box 29

top soil

1 3

Belzoni, MS

brigan sand

3 15

(mailing address)

red clay

15 210

WELL LOCATION:

course white sand

210 240

sec. 4 T 6 N S R 10 E W

cut blue clay

240 380

wood market

hard blue clay

380 465

(distance) miles (direction) of (nearest town)

fine water sand

465 475

hard water sand

475 485

WELL PURPOSE: home
(home, irrigation, municipal, industrial)

WELL COMPLETION DATA:

- (1) diameter (inches) 4" x 2"
- (2) total depth (feet) 485
- (3) static water level (feet) 15 below above top of ground.

(4) casing PVC 470
(material) (depth)

4" x 2" (size) if telescope see back.

(5) screen 15' 470
(length) (depth to top)

2" (size) PVC (material)

(6) pump 1 1/2 (HP) 25 (yield gpm)

alc (type power)

(7) electric log No (yes or no)

(organization running log)

(8) how well bottom plugged 2" back wash valve 19-0

DRILLERS REMARKS: none

RECEIVED
FEB 14 1986

Department of Natural Resources
Bureau of Land & Water Resources

If well telescopes please sketch and show depths.


GROUND LEVEL

160 4" pvc
casing

325' 2" pvc
casing

15' 2" pvc
screen

2" backwash valve

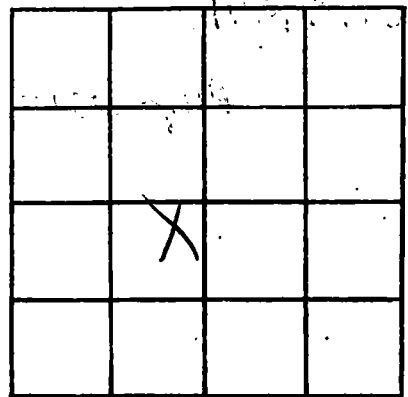

SECTION _____

Please indicate well location X.

ADDITIONAL INFORMATION

If more than one screen, show locations of each on sketch.