

MISSISSIPPI DEPARTMENT OF NATURAL RESOURCES

Bureau of Land and Water Resources

Southport Mall

P.O. Box 10631

Jackson, Mississippi 39209

WATER WELL DRILLERS LOG

CENTRAL DRILLING & SERVICE CO.

Harrison

2247

Nov. 1, 1984
date well completed

Rt. 11, Box 21
well name

Harrison
county well located

LANDOWNER: Bill Crabb

Rt. 39 Box 1549

Biloxi, MS

(mailing address)

WELL LOCATION:

sec. 3 T 6 N R 10 E
S W

Woolmarket

(distance) miles (direction) of (nearest town)

WELL PURPOSE: home
(home, irrigation, municipal, industrial)

WELL COMPLETION DATA:

- (1) diameter (inches) 2"
- (2) total depth (feet) 220
- (3) static water level (feet) 10 below above top of ground.

(4) casing PVC, 210,
(material) (depth)

(size) if telescope see back.

(5) screen 10', 210
(length) (depth to top)

2", PVC
(size) (material)

(6) pump 1, 79
(HP) (yield gpm)

alc.
(type power)

(7) electric log no
(yes or no)

(organization running log)

(8) how well bottom plugged 2" back wash valve 19-B

DRILLERS REMARKS: None

description of formations encountered

from to

top soil	1	5
sugar sand	5	25
red clay	25	120
course white sand	120	140
hard blue clay	140	200
fine water sand	200	210
good water sand	210	220


RECEIVED
FEB 14 1986

Department of Natural Resources
Bureau of Land & Water Resources

If well telescopes please sketch and show depths.

GROUND LEVEL

[Faint, illegible handwritten notes in the left column]

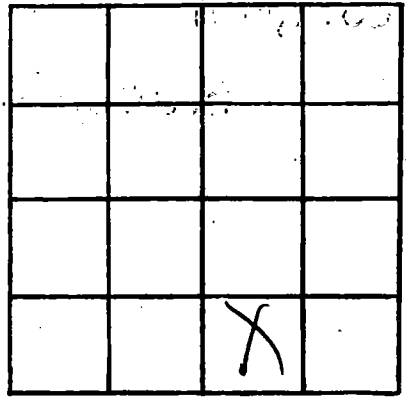

SECTION _____

Please indicate well location X.

ADDITIONAL INFORMATION

[A series of horizontal lines for additional information, mostly blank with some faint markings.]

If more than one screen, show locations of each on sketch.