

MISSISSIPPI DEPARTMENT OF NATURAL RESOURCES

Bureau of Land and Water Resources

Southport Mall

P.O. Box 10631

Jackson, Mississippi 39209

WATER WELL DRILLERS LOG

H 2253
Harrison
12-11-84

12/11/84
date well completed

19 Lyman Well Co
firm name

Harrison
county well located

LANDOWNER: O.J. Fireman
Rt. 2, Box 282
Biloxi, Md 39532
 (mailing address)

description of formations encountered	from	to
yellow clay	0	20
red sand	20	40
gravel & fine sand	40	60
sand	60	80
white clay	80	100
blue clay	100	120
coarse sand	120	169

WELL LOCATION:
 sec. 25 T. 6 N R. 10 E
6 miles N of Biloxi
 (distance) (direction) (nearest town)

WELL PURPOSE: Home
 (home, irrigation, municipal, industrial)


- WELL COMPLETION DATA:
- (1) diameter (inches) 2"
- (2) total depth (feet) 169'
- (3) static water level (feet) 53' below top of ground.
- (4) casing PVC 159'
 (material) (depth)
- 2"
 (size) if telescope see back.
- (5) screen 10' 159'
 (length) (depth to top)
- 2" PVC
 (size) (material)
- (6) pump N/A
 (HP) (yield gpm)
- (type power)
- (7) electric log No
 (yes or no)
- No
 (organization running log)
- (8) how well bottom plugged sand
shark

DRILLERS REMARKS:

17785
 240

If well telescopes please sketch and show depths.

GROUND LEVEL

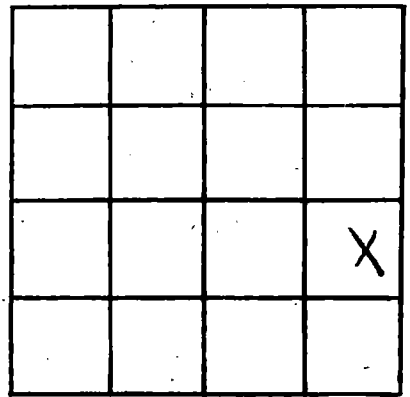

SECTION 25

Please indicate well location X.

ADDITIONAL INFORMATION

A series of horizontal lines for writing additional information.

If more than one screen, show locations of each on sketch.