

MISSISSIPPI DEPARTMENT OF NATURAL RESOURCES
Bureau of Land and Water Resources
 Southport Mall
 P.O. Box 10631
 Jackson, Mississippi 39209
WATER WELL DRILLERS LOG

Harrison
H 2254

12-18 date well completed 1984 Braden Pump & Well Sew. firm name Harrison county well located

LANDOWNER:	description of formations encountered	from	to
<u>Darrel Snowy</u>	<u>clay</u>	<u>0</u>	<u>20</u>
<u>184 N. Bend Dr., Biloxi</u> (mailing address)	<u>sand</u>	<u>20</u>	<u>90</u>
	<u>Blue clay</u>	<u>90</u>	<u>260</u>
	<u>Sand</u>	<u>260</u>	<u>274</u>
	<u>Clay</u>	<u>274</u>	<u>284</u>
WELL LOCATION: sec <u>36</u> T. <u>6</u> S. R. <u>10</u> W. <u>4</u> miles <u>NE</u> of <u>Woodmarket</u> (distance) (direction) (nearest town)			
WELL PURPOSE: <u>home</u> (home, irrigation, municipal, industrial)			
WELL COMPLETION DATA:			
(1) diameter (inches) <u>2"</u>			
(2) total depth (feet) <u>284</u>			
(3) static water level (feet) <u>20</u> below top of ground.			
(4) casing <u>PVC</u> <u>274'</u> (material) (depth)			
<u>2"</u> If telescope see back. (size)			
(5) screen <u>10'</u> <u>264</u> (length) (depth to top)			
<u>2"</u> <u>PVC .08</u> (size) (material)			
(6) pump <u>1HP</u> <u>10</u> (HP) (yield gpm)			
<u>230 volts</u> (type power)			
(7) electric log <u>NO</u> (yes or no)			
<u>NO</u> (organization running log)			
(8) how well bottom plugged <u>2" sand Shark</u>			
DRILLERS REMARKS: <u>10' tailpipe</u>			


DEPT. OF NATURAL RESOURCES
 BUREAU OF LAND & WATER RESOURCES

DEC 27 1984

RECEIVED

If well telescopes please sketch and show depths.

GROUND LEVEL

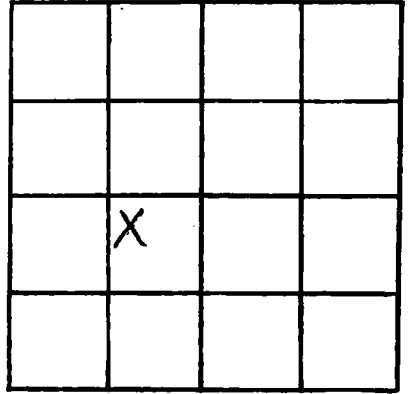

SECTION 36

Please indicate well location X.

ADDITIONAL INFORMATION

If more than one screen,
show locations of each on sketch.