

MISSISSIPPI DEPARTMENT OF NATURAL RESOURCES

Bureau of Land and Water Resources

Southport Mall

P.O. Box 10631

Jackson, Mississippi 39209

WATER WELL DRILLERS LOG

COASTAL DRILLING & SERVICE CO.

ROUTE 1 BOX 618

county well located

BILOXI, MISS. 39532

Harrison
H 2257
2-15-84

2/15/84
date well completed

LANDOWNER

Lang Jones
Walnut Road

Biloxi MS 39582
(mailing address)

WELL LOCATION:

sec 34 T 6 N R 10
S SW
Walnut Road
(distance) (direction) (nearest town)

WELL PURPOSE:

home
(home, irrigation, municipal, industrial)

WELL COMPLETION DATA:

- (1) diameter (inches) 2"
- (2) total depth (feet) 540
- (3) static water level (feet) 40' below top of ground.
- (4) casing PVC 530'
(material) (depth)
(size) if telescope see back.
- (5) screen 10' 530'
(length) (depth to top)
2" PVC
(size) (material)
- (6) pump 1 1/2 10
(HP) (yield gpm)
Elc
(type power)
- (7) electric log no
(yes or no)

(organization running log)

(8) how well bottom plugged

2" back wash pipe
DRILLERS REMARKS: 19-6

description of formations encountered


description of formations encountered	from	to
Top Soil	1	3
Yellow Sand	3	20
Orange Sand	20	55
Soft Blue Clay	55	210
Grey Water Sand	210	230
Soft Blue Clay	230	210
Hard Blue Clay	310	420
Grey Water Sand	420	430
Hard Blue Clay	430	510
Grey Water Sand	510	510
Grey Water Sand	520	540

RECEIVED
JUL 22 1985

Department of Natural Resources
Bureau of Land & Water Resources

If well telescopes please sketch and show depths.

GROUND LEVEL

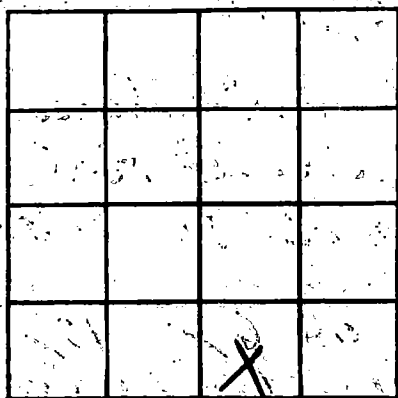

SECTION _____

Please indicate well location X.

ADDITIONAL INFORMATION

If more than one screen, show locations of each on sketch.