

MISSISSIPPI DEPARTMENT OF NATURAL RESOURCES

Bureau of Land and Water Resources

Southport Mall

P.O. Box 10631

Jackson, Mississippi 39209

WATER WELL DRILLERS LOG

COASTAL DRILLING & SERVICE CO. Harrison

HARRISON  
H  
2258

12/2/84 date well completed

Box 81

county well located

LANDOWNER: Bobby Johnson

Description of formations encountered

from to

Woolmarket Rd

top soil

1 3

Bloom, MS

sugar sand

3 20

(mailing address)

red clay

20 190

WELL LOCATION:

coarse white sand

190 210

sec. 36 T. 6 N. S. R. 40 E. W.

soft blue clay

210 390

coarse white sand

390 420

Woolmarket Rd

hard blue clay

420 480

(distance) (direction) (nearest town)

fine water sand

480 490

hard water sand

490 500

WELL PURPOSE: HOME (home, irrigation, municipal, industrial)

WELL COMPLETION DATA:

- (1) diameter (inches) 2"
- (2) total depth (feet) 500'
- (3) static water level (feet) 10' below top of ground.

- (4) casing PVC, 490' (material) (depth)

(size) If telescope see back.

- (5) screen 10', 490' (length) (depth to top)

2" PVC (size) (material)

- (6) pump 1 HP, 10 (type power) (yield gpm)

Etc. (type power)

- (7) electric log NO (yes or no)

(organization running log)

- (8) how well bottom plugged 2" back washable, 19-B

DRILLERS REMARKS:


RECEIVED

AUG - 5 1985

Department of Natural Resources  
Bureau of Land & Water Resources

If well telescopes please sketch and show depths.

GROUND LEVEL

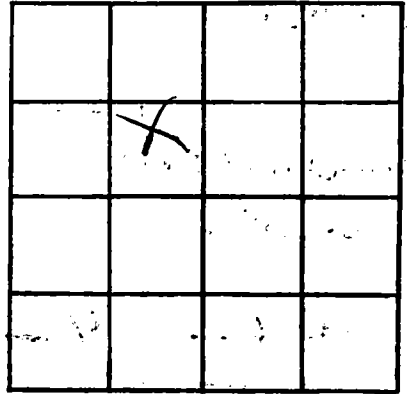

SECTION \_\_\_\_\_

Please indicate well location X.

**ADDITIONAL INFORMATION**

Lined area for additional information.

If more than one screen, show locations of each on sketch.