

MISSISSIPPI DEPARTMENT OF NATURAL RESOURCES

Bureau of Land and Water Resources

Southport Mall

P.O. Box 10631

Jackson, Mississippi 39209

WATER WELL DRILLERS LOG

COASTAL DRILLING & SERVICE CO.

Harrison  
H 2261  
5-8-84

5/8/84

date well completed

ROUTE 1 BOX 518

Harrison  
county well located

LANDOWNER: R.M. Leachard

Biloxi, Miss. 39532

description of formations encountered

from to

Rt. 10 Box 51

top soil

1 3

Biloxi, Ms

red clay

3 20

(mailing address)

sugar sand

20 45

WELL LOCATION:

course white sand

45 80

sec. 10 T. 6 N. R. 10 E.

soft blue clay

80 190

Biloxi

hard blue clay

190 280

(distance) (direction) (nearest town)

rock

280 360

WELL PURPOSE: HOME  
(home, irrigation, municipal, industrial)

course white sand

360 420

WELL COMPLETION DATA:

hard blue clay

420 660

(1) diameter (inches) 2"

fine water sand

660 700

good water sand

700 715

(2) total depth (feet) 715

(3) static water level (feet) 105 below top of ground

(4) casing PVC 705 (material) (depth)

(size) if telescope see back.

(5) screen 10' 705 (length) (depth to top)

2' PVC (size) (material)

(6) pump 1 1810 (HP) (yield gpm)

etc. (type power)

(7) electric log NO (yes or no)

(organization running log)

(8) how well bottom plugged 2' back wash valve 19-B


DRILLERS REMARKS:

RECEIVED  
JUL 22 1985

Department of Natural Resources  
Bureau of Land & Water

If well telescopes please sketch and show depths.

GROUND LEVEL

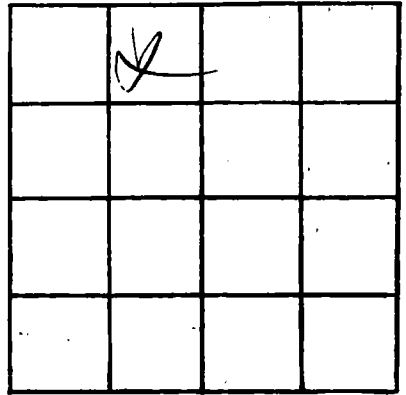

SECTION \_\_\_\_\_

Please indicate well location X.

ADDITIONAL INFORMATION

If more than one screen, show locations of each on sketch.